

LAWRENCE MISSISSIPPI BOARD OF WATER COMMISSIONERS

WATER WELL DRILLERS LOG

CODED

M 6

7-12-66

Date: 7/12/66, 1966, Driller: T.B. Andrews County Lawrence

(Name)

(1) Owner of Land: <u>Turney, Bradwell</u> (Name)	Description & Color of Materials Sand, Clay, Red Clay, Shell, etc.	Thick- ness Feet	Depth Feet
<u>Spartanville, Miss</u> (Address)	<u>0' to 40'</u> <u>Red Clay</u>		
(2) Location: <u>1/4, 1/4, Sec. 10 T. 5 R. 10</u> <u>5 miles N.E. of Spartanville</u> (distance) (direction) (Nearest Town)	<u>40' to 60'</u> <u>Gravel</u>		
(3) Topography: <u>Hilly</u> (Hilly) (Flat) (Level)	<u>60' to 80'</u>		
(4) Purpose of Well: <u>Domestic</u> (Domestic Irrigation Municipal, Industrial, Other)	<u>Sand & gravel</u>		

Information upon completion of well:


- (1) Diameter 4 inches.
- (2) Total Depth 80 feet.
- (3) Water Level 60 feet below top of ground.
- (4) Cased to 80', Size 4"
- (5) Screen: Size 4", Length 6"
- (6) Were any formations sealed against pollution?
 yes, no.

If YES depth of formation _____

Why _____

Drillers Remarks:

Plastic well

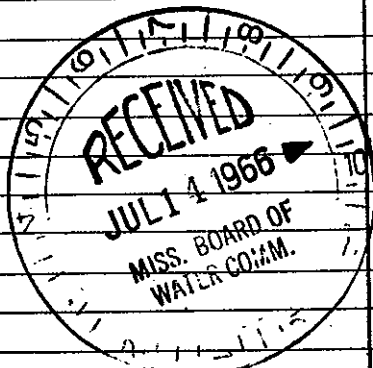

Well No.

(Use Back Side)

Mail this copy to Board of Water Commissioners 429 Miss. St. Jackson, Miss.