

CODED

MISSISSIPPI
BOARD OF WATER COMMISSIONERS
416 North State Street
Jackson, Mississippi 39201

WATER WELL DRILLERS LOG

Lawrence
M 9
11-67

11-13-19 69 Fitzgerald Water Well Drilling Lawrence
date well completed firm name county well located

LANDOWNER: J. H. Alexander
Rt 2 Jayess Miss
(mailing address)

description of formations encountered	from	to
top soil & clay	0	12
Red sand	12	55
Chalk	55	85
Fine sand	85	100
Medium sand	100	115


WELL LOCATION:
sec. 35 T. 5 N. ✓ R. 10 E. ✓
S. W.
2 miles E of Jayess
(distance) (direction) (nearest town)

Chalk

WELL PURPOSE: home
(home, irrigation, municipal, industrial)

WELL COMPLETION DATA:

- (1) diameter (inches) 4 1/2"
- (2) total depth (feet) 115
- (3) static water level (feet) 8 below above top of ground.
- (4) casing plastic 10"
(material) (depth)
4"
(size) if telescope see back.
- (5) screen 8 10"
(length) (depth to top)
4" plastic
(size) (material)
- (6) pump 1/2 hp 129 gpm
(HP) (yield gpm)
Spec
(type power)
- (7) electric log no
(yes or no)
- (8) how well bottom plugged Wood peg

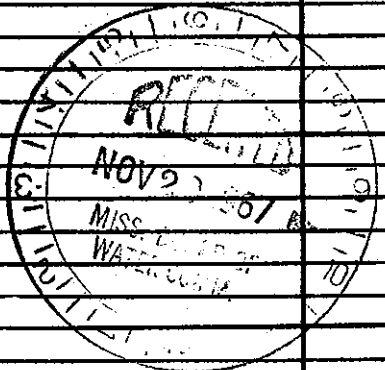

DRILLERS REMARKS: