

Lawrence
M10
2-68

MISSISSIPPI
BOARD OF WATER COMMISSIONERS
416 North State Street
Jackson, Mississippi 39201

CODED

WATER WELL DRILLERS LOG

2-13-68 date well completed
Fitzgerald Water Well Lawrence firm name
Lawrence county well located


LANDOWNER: Robert Earl Bullock
James Pt 2 MISS
(mailing address)

description of formations encountered	from	to
Top soil & clay	0	16
Sand	16	50
Chalk	50	118
Gravel	118	124
Chalk	124	158
Gravel	158	196
White Chalk	196	

WELL LOCATION:
sec. 22 T. 5 N. R. 11 E. S. 1 W.
2 miles NE James (distance) (direction) of (nearest town)

WELL PURPOSE: home
(home, irrigation, municipal, industrial)

WELL COMPLETION DATA:
(1) diameter (inches) 4
(2) total depth (feet) 197
(3) static water level (feet) 80 below top of ground.
(4) casing plastic 1 1/2" (material) (depth)
(5) screen 6' 191 (length) (depth to top)
(6) pump 3/4 HP 7 (type power) (yield gpm)
(7) electric log NO (yes or no)
(8) how well bottom plugged Wild peg

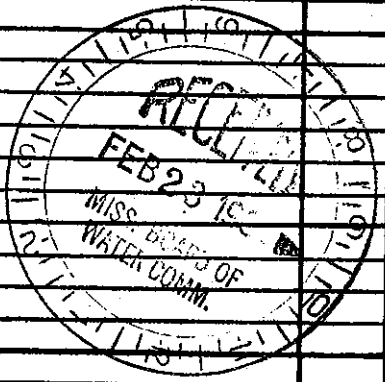

DRILLERS REMARKS: