

LAWR, MISSISSIPPI BOARD OF WATER COMMISSIONERS

M 15

3-19-63 WATER WELL DRILLERS LOG

OK DRUG CODED


Date: 3-19, 1963, Driller: Chester Reeves Lawrence  
(Name)

(1) Owner of Land: Jack Maxwell  
(Name)  
Jaxess  
(Address)  
28 5-10 E  
(2) Location: 1/4, 1/4, Sec. T. R.  
1 miles North of Jaxess  
(distance) (direction) (Nearest Town)  
(3) Topography: Hilly  
(Hilly) (Flat) (Level)  
(4) Purpose of Well: Domestic  
(Domestic Irrigation  
Municipal, Industrial, Other)

Description & Color of Materials Sand, Clay, Red Clay, Shell, etc.	Thick- ness Feet	De Pt.
Clay	20	20
Red sand	60	80
Red Clay	10	90
Red sand	10	100
Sand & gravel	15	115

Information upon completion of well:

(1) Diameter 2 inches  
(2) Total Depth 115 feet  
(3) Water Level \_\_\_\_\_ feet below top of ground.  
(4) Cased to 2" Size  
(5) Screen: Size 1/4", Length 6'  
(6) Were any formations sealed against pollution?  
\_\_\_\_\_ yes,  no.

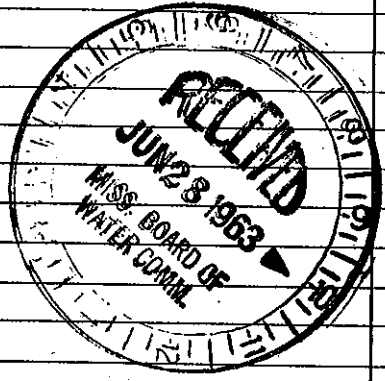

If YES depth of formation \_\_\_\_\_  
Why \_\_\_\_\_  
Drillers Remarks: good well  
Bad

REEVES WELL & PUMP CO.  
P. O. BOX 71 - PHONE 684-1451  
McCOMB, MISS.

Well No.

(Use Back Side)

ail this copy to Board of Water Commissioners 429 Miss. St. Jackson, Miss