

LAWR. MISSISSIPPI BOARD OF WATER COMMISSIONERS

M 16
4-11-63

WATER WELL DRILLERS LOG

CODED JPK

Date: 4-11, 1963, Driller: Chester Renea Lawrence
County: _____
(Name)

(1) Owner of Land: J. S. Rials
(Name)
Jaysboro
(Address)
28.5-100
(2) Location: 1/4, 1/4, Sec. T. R.
1 miles north of Jaysboro
(distance) (direction) (Nearest Town)
(3) Topography: Hilly
(Hilly) (Flat) (Level)
(4) Purpose of Well: Domestic
(Domestic Irrigation
Municipal, Industrial, Other)


Description & Color of Materials Sand, Clay, Red Clay, Shell, etc.	Thick- ness Feet	De- pth Feet
Clay	25	25
Red shaly sand	55	80
yellow sand	10	90
Red shaly sand	10	100
Small gravel sand	17	117

Information upon completion of well:

(1) Diameter 4 inches.
(2) Total Depth 117 feet.
(3) Water Level 90 feet below top of ground.
(4) Cased to bottom. Size 4
(5) Screen: Size 4", Length 4'
(6) Were any formations sealed against pollution?
yes, no.

REEVES WELL & PUMP CO.
P. O. BOX 71 -- PHONE 684-1451
MCCOMB, MISS.

If YES depth of formation _____
Why _____
Drillers Remarks:
New Haven

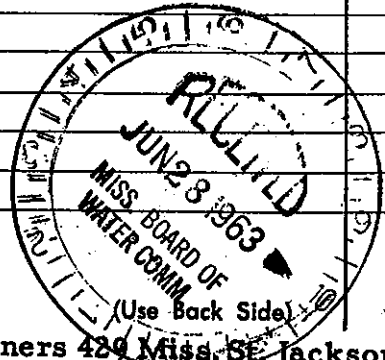

Well No. _____

Mail this copy to Board of Water Commissioners 429 Miss. St. Jackson, Miss.