

MISSISSIPPI BOARD OF WATER COMMISSIONERS

OK

LAWR.

M 17

7-18-63

WATER WELL DRILLERS LOG

CODED

Date: 7-18, 1963, Driller: Chester Reeves County: Louisiana


(Name)

(1) Owner of Land: Robert Alexander
 (Name)
Jayess -
 (Address) 33 S-10E
 (2) Location: 1/4, 1/4, Sec. T. R.
1/2 miles S.E. of Jayess
 (distance) (direction) (Nearest Town)
 (3) Topography: Hilly
 (Hilly) (Flat) (Level)
 (4) Purpose of Well: Domestic
 (Domestic Irrigation
 Municipal, Industrial, Other)

Description & Color of Materials Sand, Clay, Red Clay, Shell, etc.	Thick- ness Feet	Dept Fee
<u>Red Clay</u>	<u>30</u>	<u>30</u>
<u>Red Sand</u>	<u>88</u>	<u>118</u>
<u>Red gravel</u>	<u>15</u>	<u>133</u>

Information upon completion of well:

(1) Diameter 4 inches.
 (2) Total Depth 133 feet.
 (3) Water Level 75 feet below top of ground.
 (4) Cased to Bottom Size 4"
 (5) Screen: Size 4", Length 6"
 (6) Were any formations sealed against pollution?
 yes, no.

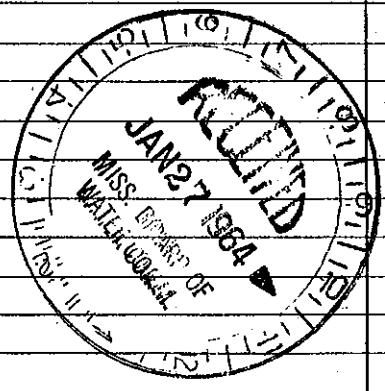

If YES: depth of formation _____
 Why _____
 Drillers' Remarks: New House

REEVES WELL & PUMP CO.
 P. O. BOX 71 PHONE 684-451
 McCOMB, MISS.

(Use Back Side)

Well No.

Retain this copy for your office files.