

LAWR.
M 19

MISSISSIPPI BOARD OF WATER COMMISSIONERS

OK

10-12-65

WATER WELL DRILLERS LOG

CODED

Date: Oct 12, 1965, Driller: Chester Lewis Lawrence

(Name)

(1) Owner of Land: P.E. Walker
(Name)
Jays
(Address) 34 S-10E

Description & Color of Materials
Sand, Clay, Red Clay, Shell, etc.
Top clay
Yellow sand
Sand & gravel

Thick-
ness
Feet
23
67
24
119

Depth
Feet
23
90
119

(2) Location: 1/4, 1/4 Sec. T. R.
1/4 miles East Jays
(distance) (direction) (Nearest Town)

(3) Topography: Hilly
(Hilly) (Flat) (Level)

(4) Purpose of Well: Domestic
(Domestic Irrigation
Municipal, Industrial, Other)


Information upon completion of well:

- (1) Diameter 4 inches.
- (2) Total Depth 119 feet.
- (3) Water Level 80 feet below top of ground.
- (4) Cased to 4" size.
- (5) Screen: Size 4", Length 7'.
- (6) Were any formations sealed against pollution?
yes, no.

If YES depth of formation

Why

Drillers Remarks: Red well
Rumped sand

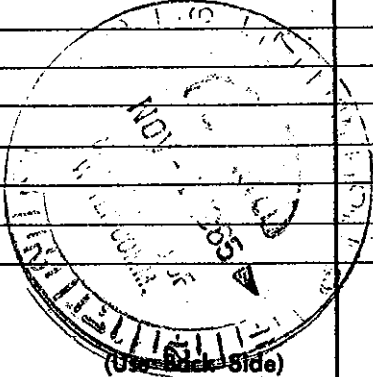

Well No.