

M21
11-6-64

OK per
CODED

WATER WELL DRILLERS LOG


Date: 11-6, 1964, Driller: Chester Reeves County: Walthall
(Name)

(1) Owner of Land:	Description & Color of Materials Sand, Clay, Red Clay, Shell, etc.	Thick- ness Feet	Depth Feet
Debra Barnett (Name)	Red Clay	30	30
RFD - Jays - (Address) 33 5-10E	Red sand & gravel	80	110
(2) Location: 2 1/2 miles N - Topeka - Teller School on Highway 77 (direction) (Nearest Town)	Red gravel & sand	17	127
(3) Topography: Hills (Hilly) (Flat) (Level)			
(4) Purpose of Well: Domestic (Domestic Irrigation Municipal, Industrial, Other)			

Information upon completion of well:

- (1) Diameter 4 inches.
- (2) Total Depth 127 feet.
- (3) Water Level 93 feet below top of ground.
- (4) Cased to bottom size 4"
- (5) Screen: Size 4", Length 7'
- (6) Were any formations sealed against pollution?
yes, no.

If YES depth of formation _____
Why _____
Drillers Remarks: New Pump

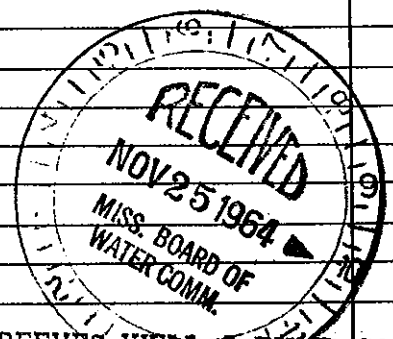

REEVES WELL & PUMP CO.
P. O. BOX 71 PHONE 684-1451
McCOMB, MISS.
(Use Back Side)

Well No.