

LAWRENCE MISSISSIPPI BOARD OF WATER COMMISSIONERS

M 22

OKAR

4-29-65

WATER WELL DRILLERS LOG

CODED

Date: 4-29, 1965, Driller: S. S. Rouse County Lawrence

(Name)

(1) Owner of Land: <u>Carl Robbins</u> (Name)	Description & Color of Materials Sand, Clay, Red Clay, Shell, etc.	Thick- ness Feet	Depth Feet
<u>Monticello Miss.</u> (Address)	<u>Red sand and gravel</u>	<u>120</u>	
(2) Location: <u>1/4, 1/4, Sec. T R</u> <u>7.5</u> miles <u>S</u> , of <u>Monticello</u> (distance) (direction) (Nearest Town)	<u>water sand & pea gravel</u>	<u>35'</u>	<u>155'</u>
(3) Topography: <input checked="" type="checkbox"/> (Hilly) <input type="checkbox"/> (Flat) <input type="checkbox"/> (Level)			
(4) Purpose of Well: <u>Domestic</u> (Domestic Irrigation Municipal, Industrial, Other)			


Information upon completion of well:

- (1) Diameter 4 inches.
- (2) Total Depth 155 feet.
- (3) Water Level 120 feet below top of ground.
- (4) Cased to 149', Size 4"
- (5) Screen: Size 4", Length 6'
- (6) Were any formations sealed against pollution?
no

If YES depth of formation _____

Why _____

Drillers Remarks: _____

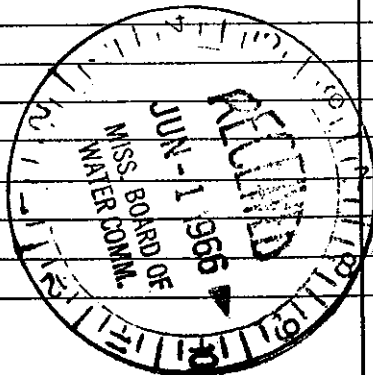

(Use Back Side)

Well No.

Mail this copy to Board of Water Commissioners 429 Miss. St. Jackson, Miss