
|                                    | Well Driller Report and Well Log                | For Office Use Only: |
|------------------------------------|---|----------------------|
| County: Lawrence                   |   |                      |
|                                    | Mississippi Department of Environmental Quality | Aquifer:             |
| Permit #: 15 610-16343             | Office of Land and Water Resources              |                      |
|                                    | P.O. Box 10631                                  | Well # : \/\_ / (    |
| Driller: Griner Drilling Service   | Jackson, MS 39289-0631                          |                      |
|                                    | (601) 961-5210                                  | L.S. Elevation:      |
| Date drilling completed: 5/13/2008 | (601) 354-6938 (fax)                            |                      |
|                                    |   | E-Log # :            |

State Law requires that this report be prepared by the driller in detail and filed with the Department within 30 days of completion of drilling of the well.

| Well Owner Information  | Well Location  |  |  |  |  |  |
|---|--|--|--|--|--|--|
| Owner Name Jayess Topeka-Tilton Water Association   | Latitude: <u>31</u> <u>24'52.16 "N</u> Longitude: <u>90</u> <u>11'16</u> .42"N |  |  |  |  |  |
| Mailing Address: 23 Bismark Rd.   | Method of Lat/Long (circle one): Conventional Survey,                          |  |  |  |  |  |
|   | USGS quad, Hand-held GPS, Survey-grade GPS Google Earth                        |  |  |  |  |  |
| Jayess MS. 39641  | NE 1/4 SW 1/4 Sec 10 Twn 5N Rng 10E  |  |  |  |  |  |
| City State Zip Code   | Distance Direction Nearest Town  |  |  |  |  |  |
| Telephone No(601) 587-2131  | 0.12 Miles South of Holmesville/Topeka-Jayess Rd.                              |  |  |  |  |  |
| Well Data   |  |  |  |  |  |  |
| Purpose of Well (circle one) Home Industrial Public Supply  | Irrigation Fish Culture Other:   |  |  |  |  |  |
| Date well drilling started:4/17/2008  | Date well drilling completed:  |  |  |  |  |  |
| If flowing, method of flow regulation: Valve  | Other (describe)   |  |  |  |  |  |
| Static Water Level: 98.65 feet above or below (circle one)  | land surface Date measured: 5-13-08  |  |  |  |  |  |
| Method of Measurement (circle one) steel tape electric tape   | air line other:  |  |  |  |  |  |
| Hole depth:270 Well depth:188   | Well grouted to a depth of128feet  |  |  |  |  |  |
| Type of grout (circle one): <u>Cement</u> Bentonite Mix   |  |  |  |  |  |  |
| Casing length: <u>128</u> feet Casing diameter: <u>20</u>   | inches Type of casing: Black Steel   |  |  |  |  |  |
| Screen length:50_feet Screen diameter:12  | inches Type of screen:304 SS   |  |  |  |  |  |
| Screen slot size: 0.020* inches Setting depth: From   | 138 feet to 188 feet   |  |  |  |  |  |
| Type of completion (circle all applicable): <u>Gravel packed Underrea</u>   | med Telescoped Open hole Natural development                                   |  |  |  |  |  |
| Other (describe):   |  |  |  |  |  |  |
|   |  |  |  |  |  |  |
| Top of lap pipe or reduction in casing: 78 feet. If telescoped or more than one screen, describe on back of page  |  |  |  |  |  |  |
| Logs run (circle all applicable): No log run Electric Gamma Ray Density Sonic Neutron Other:  |  |  |  |  |  |  |
| Name of organization running log(s): <u>Griner Drilling Service Inc.</u>  |  |  |  |  |  |  |
| certify that the well was drilled, constructed, and completed in accordance with all applicable requirements of the Mississippi Department of Environmental Quality and/or the Mississippi Department of Health regulations and state laws. |  |  |  |  |  |  |
|   |  |  |  |  |  |  |
| Charles H. Griner 0-184<br>Print Name of Water Well Contractor and License No.  | Signature of Water Well Contractor   |  |  |  |  |  |
|   |  |  |  |  |  |  |

If well telescopes please sketch below and show depths

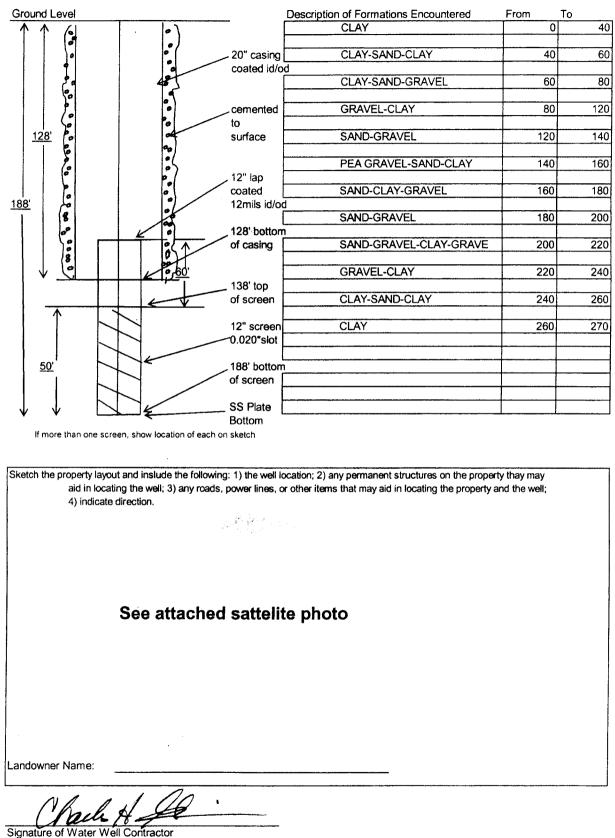

4

.\* • \* • • •

|                                      | STATE WELL REPORT                               |                      |
|--------------------------------------|---|----------------------|
| County: Lawrence                     | Part 2 Pump Installer's Completion Report       | For Office Use Only: |
|                                      |   | Aquifer:             |
| Permit #: MS-610-16343               | Mississippi Department of Environmental Quality |                      |
|                                      | Office of Land and Water Resources              | Well #:70            |
| Driller: Griner Drilling Service Inc | P.O. Box 10631                                  |                      |
|                                      | Jackson, MS 39289-0631                          | Elevation:           |
| Date Completed: 5/13/2008            | (601)961-5210                                   |                      |
|                                      | (601)354-6938 (fax)                             |                      |

This report must be prepared by the pump installer in detail and filed with the Department with 30 days of the installation of pump. A copy of Part 1 of this report must be attached to the report.

| Well Owner Information                            |                      |                   |          | Well Location  |              |          |             |            |               |                   |      |
|---|----------------------|-------------------|----------|----------------|--------------|----------|-------------|------------|---------------|-------------------|------|
| Owner Name  | lavess Topeka-Tilton | Water Association | <b>.</b> |                | Latitude: 31 | 0        | 24/52 16    | "NI        | Longitudo     | o<br>90 11'16.42" | 14/  |
| Owner Name Jayess Topeka-Tilton Water Association |                      |                   |          | Lanude. 31     | <u>'</u>     | 24 02.10 |             | _congitude | 90 11 10.42   |                   |      |
| Mailing Addres                                    | s: 23 Bismark I      | Rd.               | ····     | - <del>1</del> | Method of L  | _at/L    | ong (circle | one):      | Convention    | al Survey,        |      |
|   |                      |                   |          |                | USGS q       | uad.     | Hand-held   | GPS        | , Survey-grad | de GPS            |      |
|   | Jayess               | MS                |          | 39641          | NE           | 1/4      | SW          | 1/4        | Sec 10 1      | Twn <u>5N</u> Rng | IOE  |
|   | City                 | State             | Zip Code |                |              |          |             |            |               |                   |      |
|   |                      |                   |          |                | Distance     |          | Direction   |            | ١             | Nearest Town      |      |
| Telephone No.                                     | (601) 587-2131       |                   |          |                | 0.12 M       | liles    | South       | of         | Holmesville/  | Topeka-Jayes      | s Rd |

| Pump Type<br>Circle one |          |          |                    | Power Type<br>Circle one |                  |             |  |
|-------------------------|----------|----------|--------------------|--------------------------|------------------|-------------|--|
| Air Lift                | Jet      |          | Submersible        | Diesel Engine            | Gasoline Engine  | Natural Gas |  |
| Bucket                  | Piton    |          | Turbine            | Electric Motor           | Hand             | Tractor PTO |  |
| Centrifugal             | Rotary   |          | Flowing Well       | Windmill                 | Other (specify): |             |  |
| Other (specify          | ):       | ····.    |                    | Horse Power Ratin        | g of Motor: 40   |             |  |
| Date Pump Ins           | stalled: | 7/7/2008 |                    | Setting Depth:           | 160              | feet        |  |
| Rated Pump C            | apacity: | 600      | Gallons per minute | Number of Stages:        | 4                |             |  |

|                            | Pump Test Data   |                          | Method of Measuring Water Level                    |
|----------------------------|------------------|--------------------------|--|
| Date Well Tested:          | 5/13/2008        |                          | Circle One   |
| Static Water Level (A):    | 98.65            | Feet Below Land Surface  | Air Line <u>Electric Measuring Line</u> Steel Tape |
| Pumping Water Level (B)    | 122              | _Feet Below Land Surface | Other (specify) :                                  |
| Drawdown {(B) - (A)} :     |                  | Feet Below Land Surface  | For flowing well, measured shut in head : feet     |
| Test Pumping Rate:         | 602              | Gallons Per Minute       | Well yielded602_ GPM with a drawdown of            |
| Duration of Pump test (mir | iimum 4 hours) : | 2 4 hours                | 24 feet after24 hours of pumping                   |

I HEREBY CERTIFY that the above statements are true to the best of my knowledge.

Charles H. Griner 0-184 Print Name of Pump Installer and License No. (if applicable)

.

ي. بر عر

Signature of Pump Installer 1