

Lawrence
N 5
8-25-66

MISSISSIPPI BOARD OF WATER COMMISSIONERS

CODED

WATER WELL DRILLERS LOG

Date: 8/25, 1966, Driller: T. B. Andrews County LAWRENCE
(Name)

(1) Owner of Land:	Description & Color of Materials Sand, Clay, Red Clay, Shell, etc.	Thick- ness Feet	Depth Feet
<u>DELMUS REID</u> (Name)	<u>Red Clay</u>	<u>40'</u>	<u>40'</u>
<u>Rt. 2 Jayess, Miss</u> (Address)	<u>Sand</u>	<u>35'</u>	<u>75'</u>
(2) Location: <u>NE 1/4, NE 1/4, Sec. 19 T5 R1E</u>	<u>Sand / gravel</u>	<u>5'</u>	<u>80'</u>
<u>6</u> miles <u>W. E.</u> of <u>Spartanville</u> (distance) (direction) (Nearest Town)	<u>Chalk</u>	<u>20'</u>	<u>100'</u>
(3) Topography: <u>Hilly</u> (Hilly) (Flat) (Level)	<u>Sand / red gravel</u>	<u>20'</u>	<u>120'</u>
(4) Purpose of Well: <u>Domestic</u> (Domestic Irrigation Municipal, Industrial, Other)			

Information upon completion of well:


- (1) Diameter 4 inches.
- (2) Total Depth 120 feet.
- (3) Water Level 75 feet below top of ground.
- (4) Cased to 120, Size 4"
- (5) Screen: Size 4", Length 6'
- (6) Were any formations sealed against pollution?
 yes, no.

If YES depth of formation _____

Why _____

Drillers Remarks: _____

Plastic Well

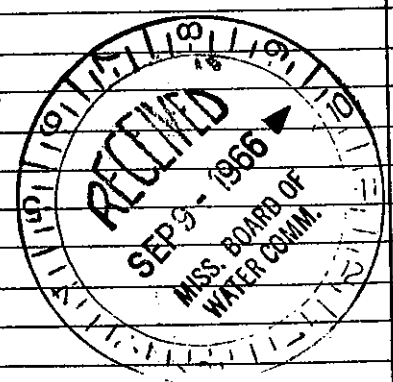

(Use Back Side)

Well No. 35