

MISSISSIPPI BOARD OF WATER COMMISSIONERS

CODED

WATER WELL DRILLERS LOG

Lawrence
No
10-66

Date: 10/20, 1966, Driller: T. B. ANDREWS County LAWRENCE
(Name)

	Description & Color of Materials Sand, Clay, Red Clay, Shell, etc.	Thick- ness Feet	Depth Feet
(1) Owner of Land: <u>Donald White</u> (Name)	<u>Red Clay</u>	<u>80</u>	<u>80</u>
Rt. 2 Box 177 <u>Jayess, Miss</u> (Address)	<u>gray clay</u>	<u>20</u>	<u>100</u>
(2) Location: <u>NE 1/4, NE 1/4, Sec. 34 T5R11</u>	<u>Sand / pea gravel</u>	<u>30</u>	<u>130</u>
<u>6</u> miles <u>N. E.</u> of <u>Spartinville</u> (distance) (direction) (Nearest Town)			
(3) Topography: <u>Hilly</u> (Hilly) (Flat) (Level)			
(4) Purpose of Well: <u>Domestic</u> (Domestic Irrigation Municipal, Industrial, Other)			

Information upon completion of well:


- (1) Diameter 4 inches.
- (2) Total Depth 130 feet.
- (3) Water Level 100 feet below top of ground.
- (4) Cased to 130', Size 4"
- (5) Screen: Size 4", Length 6"
- (6) Were any formations sealed against pollution?
 yes, no.

If YES depth of formation _____

Why _____

Drillers Remarks:

4" plastic well
subm. pump

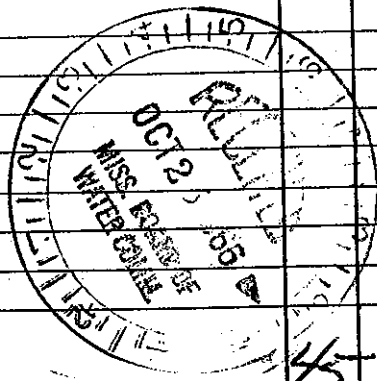

(Use Back Side)

Well No. 45

Mail this copy to Board of Water Commissioners 429 Miss. St. Jackson, Miss.