

Lawrence
N 7
12-66

MISSISSIPPI BOARD OF WATER COMMISSIONERS

CODED

WATER WELL DRILLERS LOG

Date: 12/5, 1966, Driller: T.R. Andrews County Lawrence
(When well drilled) (Name) (Where well is located)


(1) Owner of Land: John A. Tullis
(Name)
Rt. 1 Jayess, Miss
(Address)
(2) Location: SW 1/4, SE 1/4, Sec. 32, T. 11, R. 11
3 miles N.E. of Satchville
(distance) (direction) (Nearest Town)
(3) Topography: Hilly
(Hilly) (Flat) (Level)
(4) Purpose of Well: Domestic
(Domestic Irrigation, Municipal, Industrial, Other)

Description & Color of Materials Sand, Clay, Red Clay, Shell, etc.	Thick- ness Feet	Depth Feet
<u>Red Clay</u>	<u>40'</u>	<u>40'</u>
<u>gravel</u>	<u>20'</u>	<u>60'</u>
<u>Chalk</u>	<u>20'</u>	<u>80'</u>
<u>Sand</u>	<u>20'</u>	<u>100'</u>
<u>Chalk</u>	<u>20'</u>	<u>120'</u>
<u>Sand / pea gravel</u>	<u>40'</u>	<u>160'</u>

Information upon completion of well:

(1) Diameter 4 inches.
(2) Total Depth 160 feet.
(3) Water Level 80 feet below top of ground.
(4) Cased to 160', Size 4"
(5) Screen: Size 4", Length 6'
(6) Were any formations sealed against pollution?
yes, no.

If YES depth of formation _____
Why _____
Drillers Remarks: Plastic Well
Yield in gpm: 12
Size pump: Did not put in pump
Type power: Just drilled well

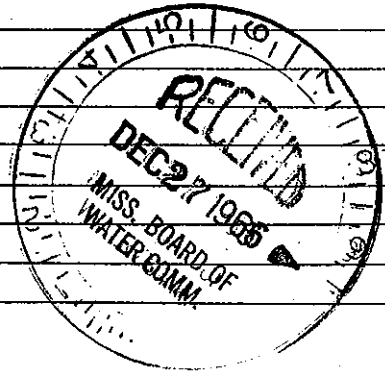

52

ail this copy to Board of Water Commissioners 429 Miss. St. Jackson, Miss.