

MISSISSIPPI BOARD OF WATER COMMISSIONERS

OKger

CODED

WATER WELL DRILLERS LOG

Date: July 13, 1966, Driller: Burney Water Well Service County: Ozark

(Name)

Inc. Lanham(1) Owner of Land: E. H. Givens

(Name)

Pattison, Miss.

(Address)

(2) Location: 1/4, 1/4, Sec. T R. E17 miles S-west of Monticello
(distance) (direction) (Nearest Town)(3) Topography: Hilly

(Hilly)

(Flat)

(Level)

(4) Purpose of Well: Domestic(Domestic Irrigation
Municipal, Industrial, Other)Description & Color of Materials
Sand, Clay, Red Clay, Shell, etc.Thick-
ness
FeetDepth
Feet

Top soil

4

4

Red sand

19

23

Pea gravel

18

41

Layers of Pipe clay

2

43

Pea Gravel

19

62

Red Clay & Sand

18

80

Pea gravel & Sand

16

96

Pipe clay & sand

11

107

Yellow sand

50

157

Pea gravel

7

164

Blue Clay

21

185

Clay & fine blue sand layers

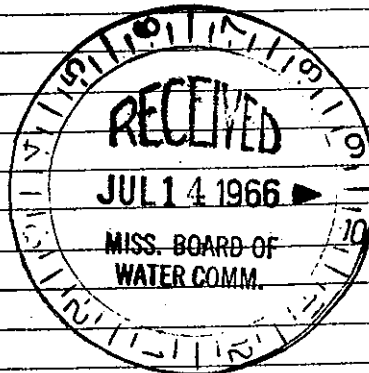
62

247

Information upon completion of well:

(1) Diameter 4" inches.(2) Total Depth 247 feet.(3) Water Level 105 feet below top of ground.(4) Cased to 158', Size 2"(5) Screen: Size 2", Length 5'

(6) Were any formations sealed against pollution?

X yes, no.If YES depth of formation From surfaceWhy To prevent surface pollutionDrillers Remarks: Sanitary well seal used

(Use Back Side)

Well No.

Mail this copy to Board of Water Commissioners 429 Miss. St. Jackson, Miss.