

LEAKE MISSISSIPPI BOARD OF WATER COMMISSIONERS


A 9
4-12-63

WATER WELL DRILLERS LOG

DODD

Date: 4-12, 19 63, Driller: Heaven Drilling County Leake
(Name)

	Description & Color of Materials Sand, Clay, Red Clay, Shell, etc.	Thick- ness Feet	Depth Feet
(1) Owner of Land: <u>Heaven High Nash</u> (Name) <u>Shomastown, Miss.</u> (Address)	<u>Hard Clay</u>	<u>10</u>	<u>10</u>
(2) Location: <u>T12N</u> <u>10</u> <u>8 E</u> 1/4, 1/4, Sec. T R	<u>Sand</u>	<u>81</u>	<u>91</u>
(3) Topography: <u>3</u> miles <u>N</u> of <u>Shomastown</u> (distance) (direction) (Nearest Town)			
(4) Purpose of Well: <u>Hilly</u> (Muddy) (Flat) (Level)			
(4) Purpose of Well: <u>Domestic</u> (Domestic Irrigation Municipal, Industrial, Other)			
Information upon completion of well:			
(1) Diameter <u>2</u> inches.			
(2) Total Depth <u>91</u> feet.			
(3) Water Level <u>70' 2"</u> feet below top of ground.			
(4) Cased to <u>84</u> , Size <u>2"</u>			
(5) Screen: Size <u>1 1/2</u> , Length <u>6' 480</u>			
(6) Were any formations sealed against pollution?			
_____ yes, _____ no.			
If YES depth of formation _____			
Why _____			
Drillers Remarks: _____			

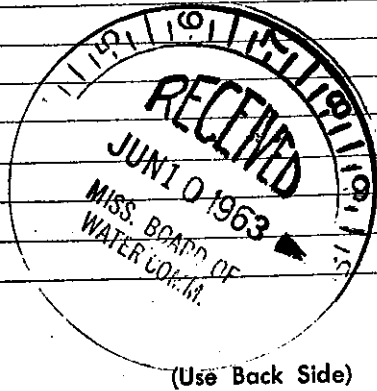

Well No.

Mail this copy to Board of Water Commissioners 429 Miss. St. Jackson, Miss