

MISSISSIPPI BOARD OF WATER COMMISSIONERS

LEAKE

A 10

6-29-62

WATER WELL DRILLERS LOG

CODED

Date: 6-29, 1962, Driller: Hearon Drilling Co. Leake

(Name)

(1) Owner of Land: James Arnold  
(Name)

Rt 3 Kosciusko  
(Address)

(2) Location: 1/4 Sec 23 T2R6  
1 miles North of Greenville  
(distance) (direction) (Nearest Town)

(3) Topography: Flat  
(Hilly) (Flat) (Level)

(4) Purpose of Well: Domestic  
(Domestic Irrigation  
Municipal, Industrial, Other)

Description & Color of Materials Sand, Clay, Red Clay, Shell, etc.	Thick- ness Feet	Depth Feet
<u>Yellow Clay</u>	<u>27</u>	<u>27</u>
<u>Yellow Sand</u>	<u>18</u>	<u>45</u>
<u>Soap Stone</u>	<u>1</u>	<u>46</u>
<u>White Sand</u>	<u>9</u>	<u>55</u>
<u>Grey Blue Clay</u>	<u>35</u>	<u>90</u>
<u>Fractured puffed clay</u>		<u>125</u>

Information upon completion of well:

(1) Diameter 2 inches.

(2) Total Depth 306 1/2 feet.

(3) Water Level 40 feet below top of ground.

(4) Cased to 296 1/2, Size 2

(5) Screen: Size 2, Length 10


(6) Were any formations sealed against pollution?

X yes, X no.

If YES depth of formation \_\_\_\_\_

Why \_\_\_\_\_

Drillers Remarks: \_\_\_\_\_

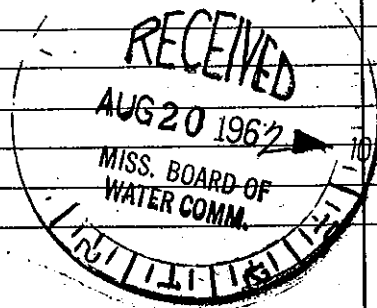

(Use Back Side)

Well No.

Mail this copy to Board of Water Commissioners 429 Miss. St. Jackson, Miss.