

LEAKE

A 12

3-22-62

WATER WELL DRILLERS LOG

CODED

Date: 3-22, 1962, Driller: J P Thornton County Lake

(Name)

	Description & Color of Materials Sand, Clay, Red Clay, Shell, etc.	Thick- ness Feet	Depth Feet
(1) Owner of Land: <u>E H Jones</u> (Name) <u>Thomastown</u> (Address)	<u>red clay</u>	<u>30</u>	<u>30</u>
(2) Location: <u>1/4</u> , <u>10</u> <u>7</u> <u>?</u> Use this <u>1/4</u> Sec. <u>T. R.</u> <u>may be moved since 1962</u>	<u>fine sand dark gray</u>	<u>40</u>	<u>70</u>
<u>25</u> miles <u>west</u> of <u>Thomastown</u> (distance) (direction) (Nearest Town)	<u>rock</u>	<u>8</u>	<u>78</u>
(3) Topography: <u>hilly</u> (Hilly) (Flat) (Level)	<u>Block dirt</u>	<u>102</u>	<u>140</u>
(4) Purpose of Well: <u>Domestic</u> (Domestic Irrigation Municipal, Industrial, Other)	<u>rock</u>	<u>6</u>	<u>146</u>
	<u>course gray water sand</u>	<u>15</u>	<u>161</u>
	<u>5206</u>		

Information upon completion of well:

(1) Diameter 2 inches.

(2) Total Depth 161 feet.

(3) Water Level 42 feet below top of ground.

(4) Cased to 148, Size 2

(5) Screen: Size 1 1/4, Length 6 ft.

(6) Were any formations sealed against pollution?


no, no.

If YES depth of formation _____

Why _____

Drillers Remarks: 415' gal per hour

609
607415.0
360
550

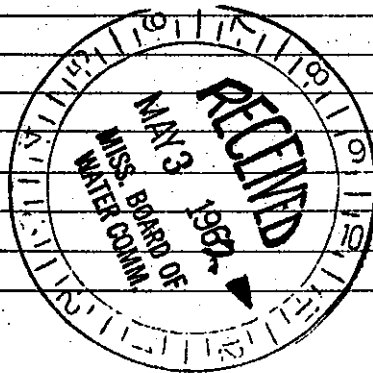

(Use Back Side)

Well No.

Mail this copy to Board of Water Commissioners 429 Miss. St. Jackson, Miss