

**LEAKE MISSISSIPPI BOARD OF WATER COMM.**

**A 13**

**WATER WELL DRILLERS LOG**

**CODED**


**8-9-62**

Date: 8-9, 1962, Driller: Hearon Drilling County Leake  
(Name)

	Description & Color of Materials Sand, Clay, Red Clay, Shell, etc.	Thick- ness Feet	Depth Feet
(1) Owner of Land: <u>Joe Wilacy</u> (Name) <u>Box 2 Rt 2 Sallis</u> (Address)	<u>Yellow Sand Clay</u>	<u>5</u>	<u>5</u>
(2) Location: <u>1/4</u> , <u>1/4</u> , Sec. <u>T</u> <u>R</u>	<u>Rock</u>	<u>-</u>	<u>-</u>
<u>1/2</u> miles <u>W</u> of <u>Thomasboro</u> (distance) (direction) (Nearest Town)	<u>Brown Clay</u>	<u>11</u>	<u>16</u>
(3) Topography: <u>Hilly</u> (Hilly) (Flat) (Level)	<u>Lignite</u>	<u>-</u>	<u>17</u>
(4) Purpose of Well: <u>Domestic</u> (Domestic Irrigation Municipal, Industrial, Other)	<u>Yellow Sand Clay</u>	<u>9</u>	<u>26</u>
	<u>Dark Grey Clay</u>	<u>31</u>	<u>57</u>
	<u>Dark Grey Pepp. Sand</u>	<u>10</u>	<u>147</u>
	<u>Dark Grey Pepp. Sand</u>	<u>100</u>	<u>127</u>
	<u>Red Grey Pepp. Sand</u>	<u>194</u>	<u>321</u>

**Information upon completion of well:**

- (1) Diameter 2 inches.
- (2) Total Depth 321 feet.
- (3) Water Level 117 feet below top of ground.
- (4) Cased to 316, Size 2
- (5) Screen: Size 2 1/4", Length 5
- (6) Were any formations sealed against pollution?  
no
- If YES depth of formation \_\_\_\_\_
- Why \_\_\_\_\_
- Drillers Remarks: \_\_\_\_\_

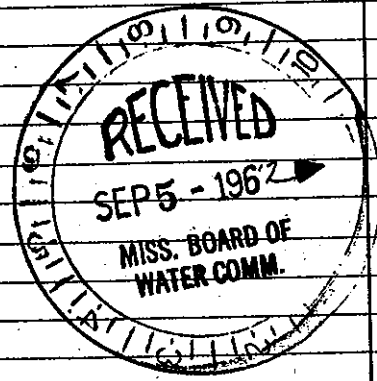

Well No.

(Use Back Side)

Mail this copy to Board of Water Commissioners 429 Miss. St. Jackson, Miss.