

LEAKE MISSISSIPPI BOARD OF WATER COMMISSIONERS

A 15

7-22-63

WATER WELL DRILLERS LOG

CODED

Date: 7-22, 1963, Driller: Theron Drilling Co County: Leflore

(Name)

(1) Owner of Land:

(Name)

Attorn Lacy
Shamestown, Miss

(Address)

(2) Location:

1/4

1/4

Sec.

T.

R.

2 1/2 miles N W
(distance)

(direction)

(Nearest Town)

(3) Topography:

(Hilly)

(Flat)

(Level)

(4) Purpose of Well:

(Domestic Irrigation
Municipal, Industrial, Other)

Domestic

Description & Color of Materials
Sand, Clay, Red Clay, Shell, etc.

Thick-
ness
Feet

Depth
Feet

<u>Dark Clay</u>	<u>20</u>	<u>20</u>
<u>Sand</u>	<u>10</u>	<u>30</u>
<u>Beach dirt</u>	<u>30</u>	<u>60</u>
<u>Levander colored clay</u>	<u>10</u>	<u>70</u>
<u>Black & Clay</u>	<u>10</u>	<u>80</u>
<u>Orange colored sand</u>	<u>10</u>	<u>90</u>
<u>Dark sand</u>	<u>50</u>	<u>140</u>
<u>White sand</u>	<u>20</u>	<u>160</u>
<u>Gray sand</u>	<u>40</u>	<u>200</u>
<u>Sand & clay mixture</u>	<u>35</u>	<u>235</u>
<u>Coarse clay</u>	<u>17</u>	<u>251</u>

Information upon completion of well:

(1) Diameter 2 inches.

(2) Total Depth 252 feet.

(3) Water Level _____ feet below top of ground.

(4) Cased to _____, Size _____.

(5) Screen: Size 2 1/2", Length 5'.

S. Steel

(6) Were any formations sealed against pollution?


_____ yes, _____ no.

If YES depth of formation _____.

Why _____.

Drillers Remarks: Air Free

Produced 1200 gals
per hour - fine
water.

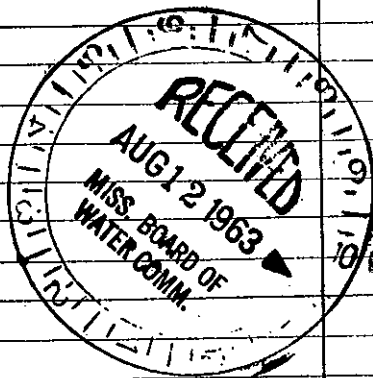

(Use Back Side)

Well No.

Mail this copy to Board of Water Commissioners 429 Miss. St. Jackson, Miss