

**LEAKE MISSISSIPPI BOARD OF WATER COMMISSIONERS**

**B 9**

**8-15-61**

**WATER WELL DRILLERS LOG**

**B CODED**

**10**

Date: 8-15, 1961, Driller: Hearon Drilling County Leake  
(Name)

(1) Owner of Land: <u>Kathie Belle Smith</u> (Name)	Description & Color of Materials Sand, Clay, Red Clay, Shell, etc.	Thick- ness Feet	Depth Feet
<u>Conway, Miss.</u> (Address)	<u>Yellow Clay</u>	<u>20</u>	<u>20</u>
(2) Location: <u>N 1/4</u> , <u>1/4</u> , Sec. <u>33</u> , T. <u>2</u> R. <u>7</u>	<u>Yellow Sand</u>	<u>6</u>	<u>26</u>
_____ miles _____ (distance) (direction) <u>in Conway</u> (Nearest Town)	<u>Sandstone Sand</u>	<u>14</u>	<u>40</u>
(3) Topography: <u>Hilly</u> (Hilly) (Flat) (Level)	<u>White Sand Puff</u>	<u>90</u>	<u>130</u>
(4) Purpose of Well: <u>Domestic</u> (Domestic Irrigation Municipal, Industrial, Other)	<u>Red Sand</u>	<u>10</u>	<u>140</u>
	<u>Sandstone Sand</u>	<u>10</u>	<u>150</u>
	<u>Blue Grey Clay</u>	<u>17</u>	<u>167</u>
	<u>White-fine Puff</u>	<u>—</u>	<u>—</u>
	<u>Sand</u>	<u>43</u>	<u>210</u>
	<u>White Puff Sand</u>	<u>23</u>	<u>233</u>

Information upon completion of well:


- (1) Diameter 2 inches.
- (2) Total Depth 233 feet.
- (3) Water Level 67 feet below top of ground.
- (4) Cased to 227 ft. Size 2"
- (5) Screen: Size 2", Length 6 ft.
- (6) Were any formations sealed against pollution?  
\_\_\_\_\_ yes,  no.

If YES depth of formation \_\_\_\_\_

Why \_\_\_\_\_

Drillers Remarks: PH 80, Iron Nails

& Hardness 2 gr./gal.

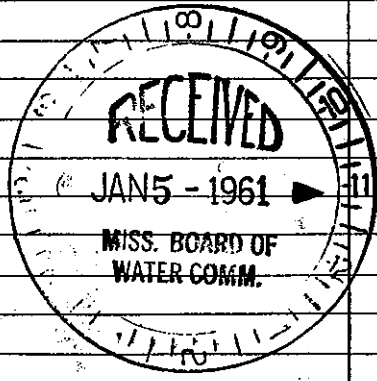

(Use Back Side)

Well No.

Mail this copy to Board of Water Commissioners 429 Miss. St. Jackson, Miss.