

LEAKE
B 10
4-11-63

MISSISSIPPI BOARD OF WATER COMMISSIONERS

WATER WELL DRILLERS LOG

CODED

Date: 4-11, 1963, Driller: Hearon County Leake

(Name)

		Description & Color of Materials Sand, Clay, Red Clay, Shell, etc.	Thick- ness Feet	Depth Feet
(1) Owner of Land:	<u>Methodist Church</u> <u>Plesant Grove</u> (Name)	<u>Red Sand Clay</u>	<u>19</u>	<u>19</u>
	<u>Carthage Rt 4</u> (Address)	<u>Cream Sand</u>	<u>8</u>	<u>27</u>
(2) Location:	<u>1/4</u> , <u>1/4</u> , Sec. <u>35</u> T <u>22</u> R <u>7</u>	<u>Soapstone & Sand</u>	<u>43</u>	<u>70</u>
	<u>8</u> miles <u>N</u> of <u>Carthage</u> (distance) (direction) (Nearest Town)	<u>Cream Peppercorn Sand</u>	<u>14</u>	<u>84</u>
(3) Topography:	<u>Hilly</u> (Hilly) (Flat) (Level)	<u>Brown Coarse Sand</u>	<u>7</u>	<u>91</u>
(4) Purpose of Well:	<u>Church</u> (Domestic Irrigation Municipal, Industrial, Other)			


Information upon completion of well:

- (1) Diameter 2 inches.
- (2) Total Depth 91 feet.
- (3) Water Level 19 feet below top of ground.
- (4) Cased to 84, Size 2"
- (5) Screen: Size 1/4, Length 4'
- (6) Were any formations sealed against pollution?
 yes, no.

If YES depth of formation _____

Why _____

Drillers Remarks: _____

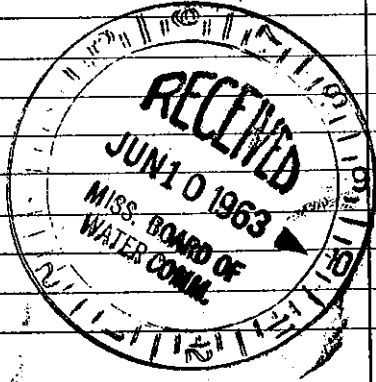

(Use Back Side)

Well No.

Mail this copy to Board of Water Commissioners 429 Miss. St. Jackson, Miss