

LEAKE MISSISSIPPI BOARD OF WATER COMMISSIONERS

B 11
6-26-63

WATER WELL DRILLERS LOG

CODED

Date: 6-26, 1963 Driller: J P Sherenton County Leake

(Name)

(1) Owner of Land: J L McHenry
(Name)
Dossuille miss
(Address)
(2) Location: 23 12 7
1/4, Sec. T. R.,
4 miles SW of Dossuille
(distance) (direction) (Nearest Town)
(3) Topography: hilly
(Hilly) (Flat) (Level)
(4) Purpose of Well: Domestic
(Domestic Irrigation
Municipal, Industrial, Other)


Description & Color of Materials Sand, Clay, Red Clay, Shell, etc.	Thick- ness Feet	Depth Feet
<u>Yellow Clay</u>	<u>35</u>	
<u>dry fine sand</u>	<u>45</u>	<u>80</u>
<u>white Chalk</u>	<u>3</u>	<u>83</u>
<u>real fine white sand</u>	<u>8</u>	<u>91</u>
<u>Chalk</u>	<u>2</u>	<u>93</u>
<u>white water sand</u>	<u>16</u>	
	<u>109</u>	

2082

Information upon completion of well:

(1) Diameter 2 inches.
(2) Total Depth 109 feet.
(3) Water Level 70 feet below top of ground.
(4) Cased to 97, Size 2".
(5) Screen: Size 1 1/4, Length 6 ft.
(6) Were any formations sealed against pollution?
_____yes, _____no.
If YES depth of formation _____

Why _____
Drillers Remarks: 325 gal per foot

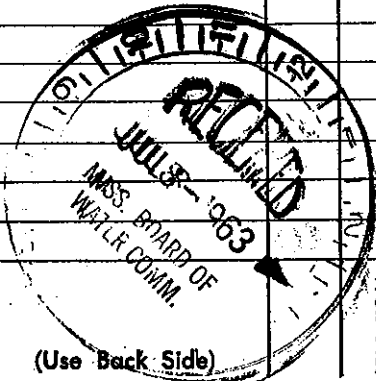

Mail this copy to Board of Water Commissioners 429 Miss. St. Jackson, Miss.