

**LEAKE MISSISSIPPI BOARD OF WATER COMMISSIONERS**

**B13**


**WATER WELL DRILLERS LOG**

**CODED**

**5-8-63**

Date: 5-8, 1963, Driller: J.P. Thornton County Leake  
(Name)

(1) Owner of Land:	Description & Color of Materials Sand, Clay, Red Clay, Shell, etc.	Thick- ness Feet	Depth Feet
<u>Joe D Henderson</u> <small>(Name)</small>	<u>red clay</u>	<u>20</u>	
<u>Dossville Miss</u> <small>(Address)</small>	<u>fine white sand</u>	<u>15</u>	<u>35</u>
(2) Location: <u>1/4, 10, 12 J</u> , <u>T. R.</u>	<u>chalk white</u>	<u>2</u>	<u>37</u>
<u>2 1/2</u> miles <u>west</u> , of <u>Dossville</u> , <small>(distance) (direction) (Nearest Town)</small>	<u>white water sand</u>	<u>18 1/2</u>	
(3) Topography: <u>hilly</u> <small>(Hilly) (Flat) (Level)</small>	<u>55 1/2</u>		
(4) Purpose of Well: <u>Domestic</u> <small>(Domestic Irrigation Municipal, Industrial, Other)</small>			
Information upon completion of well:			
(1) Diameter <u>2</u> inches.			
(2) Total Depth <u>55 1/2</u> feet.			
(3) Water Level <u>29</u> feet below top of ground.			
(4) Cased to <u>51</u> , Size <u>1 1/4</u> .			
(5) Screen: Size <u>1 1/4</u> , Length <u>4 ft long</u> .			
(6) Were any formations sealed against pollution? <u>no.</u>			
If YES depth of formation _____			
Why _____			
Drillers Remarks: <u>325 gal P<sub>2</sub> hr</u>			

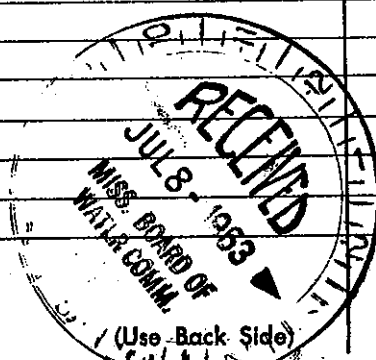

Well No.

Mail this copy to Board of Water Commissioners 429 Miss. St. Jackson, Miss