

**LEAKE MISSISSIPPI BOARD OF WATER COMMISSIONERS**

**B 15**  
**6-28-62**

**WATER WELL DRILLERS LOG**

**CODED**

Date: 6-28, 1962, Driller: J P Thornton County Leake  
(Name)

(1) Owner of Land: Ben Carroll  
(Name)  
Conway  
(Address)  
(2) Location:  $\frac{1}{4}$ , 32.127 Sec. 12 T. 7 R.  
West miles 1 (distance), of Conway (Nearest Town)  
(3) Topography: Hilly  
(Hilly) (Flat) (Level)  
(4) Purpose of Well: Domestic  
(Domestic Irrigation, Municipal, Industrial, Other)


Description & Color of Materials Sand, Clay, Red Clay, Shell, etc.	Thick- ness Feet	Depth Feet
<u>red clay</u>	<u>40</u>	
<u>pink top sand</u>	<u>15</u>	<u>55</u>
<u>white chalk</u>	<u>4</u>	<u>59</u>
<u>white water sand</u>	<u>18</u>	
	<u>77</u>	

4094

**Information upon completion of well:**

(1) Diameter 2 inches.  
(2) Total Depth 77 feet.  
(3) Water Level 38 feet below top of ground.  
(4) Cased to 70 1/2, Size 2"  
(5) Screen: Size 1 1/4, Length 6 ft  
(6) Were any formations sealed against pollution?  
no  
If YES depth of formation \_\_\_\_\_  
Why \_\_\_\_\_

Drillers Remarks: 311 gal per hour

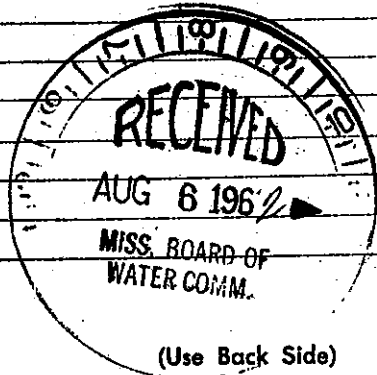

Well No.

Mail this copy to Board of Water Commissioners 429 Miss. St. Jackson, Miss