

B 76
6-11-62

CODED

WATER WELL DRILLERS LOG

Date: 6-11, 1962, Driller: J P Thornton County Leflore
(Name)

(1) Owner of Land: <u>O.M. Boyd.</u> (Name) <u>Carthage miss</u> (Address)	Description & Color of Materials Sand, Clay, Red Clay, Shell, etc.	Thick- ness Feet	Depth Feet
(2) Location: <u>2 1/4 Sec. 127</u> <u>9 miles north</u> of <u>Carthage</u> (distance) (direction) (Nearest Town)	<u>red clay</u>	<u>30</u>	
(3) Topography: <u>Hilly</u> (Hilly) (Flat) (Level)	<u>red sand</u>	<u>10</u>	<u>40</u>
(4) Purpose of Well: <u>Domestic</u> (Domestic Irrigation Municipal, Industrial, Other)	<u>shell rock</u>	<u>2</u>	<u>42</u>
	<u>pink sand</u>	<u>8</u>	<u>50</u>
	<u>white fine sand</u>	<u>20</u>	<u>70</u>
	<u>Chalk</u>	<u>6</u>	<u>76</u>
	<u>gray water sand</u>	<u>20</u>	
		<u>96</u>	

Information upon completion of well:


- (1) Diameter 2" inches.
- (2) Total Depth 96 feet.
- (3) Water Level 50 feet below top of ground.
- (4) Cased to 84, Size 2"
- (5) Screen: Size 1 1/4, Length 6 ft
- (6) Were any formations sealed against pollution?
_____ yes, _____ X no.

If YES depth of formation _____

Why _____

Drillers Remarks: 396 gal per hr.
30 55
210 90

1929-3657

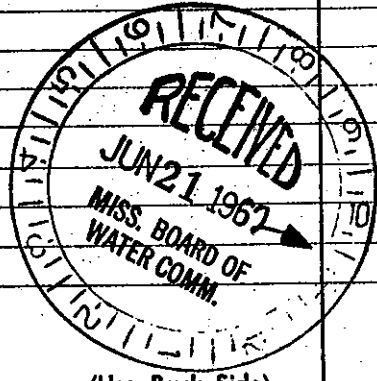

(Use Back Side)

Well No.