

**LEAKE**  
**B 51**  
**2-18-74**

MISSISSIPPI  
 BOARD OF WATER COMMISSIONERS  
 416 North State Street  
 Jackson, Mississippi 39201

**CODED**

**WATER WELL DRILLERS LOG**

2-18-1974 date well completed  
 Thomas & Son firm name  
 Leake county well located

LANDOWNER: Wess Nash  
Carthage, Miss.

(mailing address)

**WELL LOCATION:**

sec. 9 T 12 N R 7 E S W

11 miles NW of Carthage  
 (distance) (direction) (nearest town)

**WELL PURPOSE:**

(home) irrigation, municipal, industrial


**WELL COMPLETION DATA:**

- (1) diameter (inches) 2
- (2) total depth (feet) 118
- (3) static water level (feet) 92 below top of ground above
- (4) casing PVC, 112  
 (material) (depth)  
2  
 (size) if telescope see back.
- (5) screen 6, 112  
 (length) (depth to top)  
2" 3/8" slot PVC  
 (size) (material)
- (6) pump 1, 6  
 (HP) (yield gpm)  
elec.  
 (type power)
- (7) electric log MB  
 (yes or no)
- (organization running log)
- (8) how well bottom plugged Paint

description of formations encountered

	from	to
<u>Pine CLAY</u>	<u>0</u>	<u>31</u>
<u>Red SAND</u>	<u>31</u>	<u>84</u>
<u>Fine SAND</u>	<u>84</u>	<u>104</u>
<u>Chalk</u>	<u>104</u>	<u>112</u>
<u>Coarse SAND</u>	<u>112</u>	<u>118</u>

**CODED**

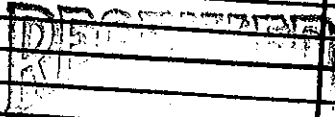

FEB 9

DRILLERS REMARKS: