

**LEAKE** MISSISSIPPI BOARD OF WATER COMMISSIONERS  
**C3**


CODED  
**H 302**

**WATER WELL DRILLERS LOG**

**8-9-60**

Date: **8-9** 19**60**, Driller: **J P Thornton** County **Leake**  
 (Name)

(1) Owner of Land: <u>Willie Martin</u> (Name)	Description & Color of Materials Sand, Clay, Red Clay, Shell, etc.	Thick- ness Feet	Depth Feet
<u>Carrhoge miss</u> (Address)	<u>hard clay</u>	<u>30</u>	
(2) Location: <u>1/4, 1/4, Sec 34 T11R9</u>	<u>Shell Rock sand</u>	<u>20</u>	<u>50</u>
<u>9 miles N.E. of Carrhoge</u> (distance) (direction) (Nearest Town)	<u>Black silt</u>	<u>12</u>	<u>62</u>
(3) Topography: <u>Hilly</u> (Hilly) (Flat) (Level)	<u>White sand</u>	<u>10</u>	
(4) Purpose of Well: <u>Domestic house hold</u> (Domestic Irrigation, Municipal, Industrial, Other)	<u>gray water sand</u>	<u>9</u>	
Information upon completion of well:			
(1) Diameter <u>2</u> inches.			
(2) Total Depth <u>81</u> feet.			
(3) Water Level <u>50</u> feet below top of ground.			
(4) Cased to <u>76</u> , Size <u>2"</u>			
(5) Screen: Size <u>1 1/4 80 gauge</u> , Length <u>5 ft.</u>			
(6) Were any formations sealed against pollution?			
<u>no</u> yes, <u>X</u> no.			
If YES depth of formation _____			
Why _____			
Drillers Remarks: <u>390 gallon per hour</u>			

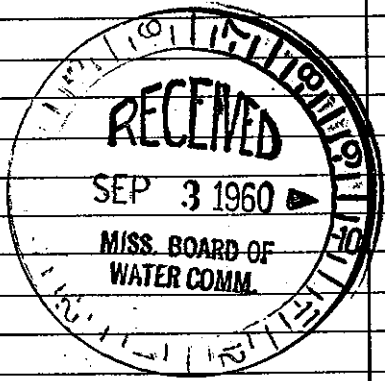

(Use Back Side)

Well No.

Mail this copy to Board of Water Commissioners 429 Miss. St. Jackson, Miss.