

LEAKE MISSISSIPPI BOARD OF WATER COMMISSIONERS

C 5
1-31-62

CODED
CODED

WATER WELL DRILLERS LOG


Date: 1-31, 1962, Driller: Hearn Drilling Co. Leake
(Name)

(1) Owner of Land:	Description & Color of Materials Sand, Clay, Red Clay, Shell, etc.	Thick- ness Feet	Depth Feet
<u>Leman Edwards</u> (Name)	<u>Red clay</u>	<u>12</u>	<u>12</u>
<u>Rt 7 Carthage, Miss</u> (Address)	<u>Red-yellow sand clay</u>	<u>10</u>	<u>22</u>
<u>N 1/4, S 1/4, Sec. 18 T2 R8E</u>	<u>yellow sand clay</u>	<u>8</u>	<u>30</u>
<u>12 miles N</u> of <u>Carthage</u> (distance) (direction) (Nearest Town)	<u>white sand</u>	<u>22</u>	<u>52</u>
(2) Location:			
(3) Topography: <u>Hilly</u> (Hilly) (Flat) (Level)			
(4) Purpose of Well: <u>Domestic</u> (Domestic Irrigation Municipal, Industrial, Other)			

Information upon completion of well:

- (1) Diameter 2 inches.
- (2) Total Depth 52 feet.
- (3) Water Level 20 feet below top of ground.
- (4) Cased to 45, Size 2.
- (5) Screen: Size 1/4, Length 4ft.
- (6) Were any formations sealed against pollution?
_____ yes, no.

If YES depth of formation _____
Why _____
Drillers Remarks: _____

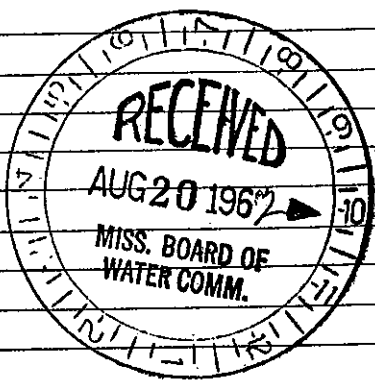

Well No.

(Use Back Side)

Mail this copy to Board of Water Commissioners 429 Miss. St. Jackson, Miss.