

MISSISSIPPI BOARD OF WATER COMMISSIONERS

LEAKE

C 6

WATER WELL DRILLERS LOG

CODED

10-11-63

Date: 10-11, 1963, Driller: THOMAS & SON County LEAKE

(Name)

(1) Owner of Land:	Description & Color of Materials Sand, Clay, Red Clay, Shell, etc.	Thick- ness Feet	Depth Feet
Mr. Richardson (Name) Carthage, Miss. (Address)	Red clay	20	0-20
(2) Location: NE 1/4, SE 1/4, Sec. 25 T12R9	Red Mealy Sand	15	20
9 miles NE of Carthage (distance) (direction) (Nearest Town)	Chalk & sand	20	35
(3) Topography: Hilly (Hilly) (Flat) (Level)	Coarse Blue Sand	19	55
(4) Purpose of Well: Domestic (Domestic Irrigation Municipal, Industrial, Other)			


Information upon completion of well:

- (1) Diameter 2 inches.
- (2) Total Depth 69 feet.
- (3) Water Level 30 feet below top of ground.
- (4) Cased to 63, Size 2"
- (5) Screen: Size 60G., Length 6 Ft.
- (6) Were any formations sealed against pollution?
 yes, no.

If YES depth of formation _____

Why _____

Drillers Remarks: _____

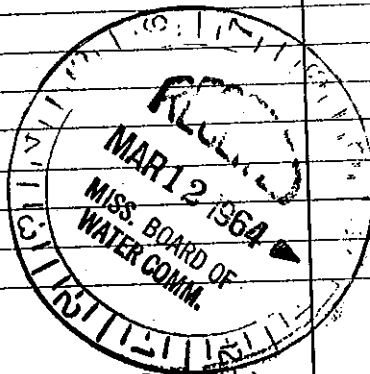

(Use Back Side)

Well No.

Mail this copy to Board of Water Commissioners 429 Miss. St. Jackson, Miss.