

Leake
C B

9-66 MISSISSIPPI BOARD OF WATER COMMISSIONERS

CODED

WATER WELL DRILLERS LOG

Date: 9-16, 1966, Driller: J P Thornton County Trall
(When well drilled) (Name) (Where well is located)

(1) Owner of Land: Edwin E Tolson
(Name)
Po Box 65 Carhoge Miss
(Address)
E 1/2 of
(2) Location: 1/4 SW 1/4, Sec. 5 T. 18 N. R. 8 E
13 miles N.E. of Carhoge
(distance) (direction) (Nearest Town)

(3) Topography: X
(Hilly) (Flat) (Level)

(4) Purpose of Well: Domestic
(Domestic Irrigation
Municipal, Industrial, Other)

Description & Color of Materials Sand, Clay, Red Clay, Shell, etc.	Thick- ness Feet	Depth Feet
<u>pink Chalk</u>	<u>15</u>	<u>15</u>
<u>Shell Rock</u>	<u>2</u>	<u>17</u>
<u>white Chalk</u>	<u>10</u>	<u>27</u>
<u>dry yellow sand</u>	<u>25</u>	<u>52</u>
<u>white water sand</u>	<u>33</u>	<u>85</u>

Information upon completion of well:

(1) Diameter 2 inches.

(2) Total Depth 85' feet.

(3) Water Level 37 feet below top of ground.

(4) Cased to 79, Size 2"

(5) Screen: Size 1/4, Length 6 ft

(6) Were any formations sealed against pollution?
_____ yes, _____ X no.


If YES depth of formation _____
Why _____

Drillers Remarks: 3

Yield in gpm: 6 gal Per min

Size pump: 1.5 HP Monark Perchuck Pump

Type power: 220

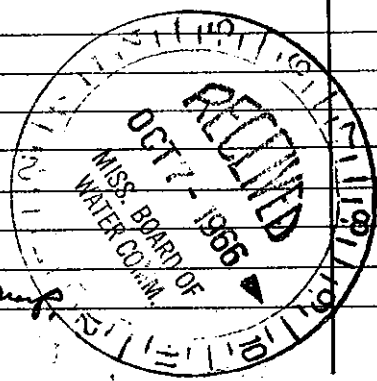

Retain this copy for your office files.