

BC9
3-4-63

CODED

WATER WELL DRILLERS LOG

Date: 3-4, 1963, Driller: J P Thornton County Leake
(Name)

	Description & Color of Materials Sand, Clay, Red Clay, Shell, etc.	Thick- ness - Feet	Depth Feet
(1) Owner of Land: <u>Hugh Tolleson</u> (Name)	<u>Red Clay</u>	<u>55</u>	
<u>Carthage miss</u> (Address)	<u>dry sand</u>	<u>10</u>	<u>65</u>
(2) Location: <u>5 12 8</u> 1/4, Sec. T. R.	<u>Chalk</u>	<u>3</u>	<u>68</u>
<u>13</u> miles <u>N</u> of <u>Carthage</u> (distance) (direction) (Nearest Town)	<u>fine water sand</u>	<u>20</u>	<u>88</u>
(3) Topography: <u>hilly</u> (Hilly) (Flat) (Level)	<u>Chalk</u>	<u>3</u>	<u>91</u>
(4) Purpose of Well: <u>Domestic</u> (Domestic Irrigation Municipal, Industrial, Other)	<u>white coarse sand</u>	<u>14</u>	
			<u>105</u>

4072


Information upon completion of well:

- (1) Diameter 2 inches.
- (2) Total Depth 105' feet.
- (3) Water level 65' feet below top of ground.
- (4) Cased to 99, Size 2"
- (5) Screen: Size 1 1/4, Length 6ft
- (6) Were any formations sealed against pollution?
_____ yes, _____ no.

If YES depth of formation _____

Why _____

Drillers Remarks: 35' gal per hr

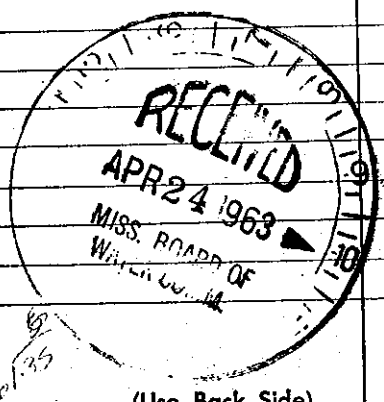

(Use Back Side)

Well No.