

LEAKE MISSISSIPPI BOARD OF WATER COMMISSIONERS

C 10

5-10-63

WATER WELL DRILLERS LOG

CODED

Date: 5-10, 1963, Driller: J.P. Thornton County Leake
(Name)

(1) Owner of Land: Eld Hollis
(Name)
Carthage Miss
(Address)

(2) Location: $\frac{1}{4}$, 25 1/2, Sec. 8, T. 1, R. 1,
9 miles NE of Carthage,
(distance) (direction) (Nearest Town)

(3) Topography: Hilly
(Hilly) (Flat) (Level)

(4) Purpose of Well: Domestic
(Domestic Irrigation
Municipal, Industrial, Other)

Description & Color of Materials Sand, Clay, Red Clay, Shell, etc.	Thick- ness Feet	Depth Feet
Red Clay	25	
dry sand	7	
Rock Shell	2	
Block dirt	46	
fine block sand	20	
sand + shell mixed	10	
Rock	2	
gray water sand	29	
	<u>141</u>	

Information upon completion of well:

(1) Diameter 2 inches.

(2) Total Depth 141 feet.

(3) Water Level 80 feet below top of ground.

(4) Cased to 133, Size 2"

(5) Screen: Size 1 1/4, Length 6 ft.


(6) Were any formations sealed against pollution?
_____ yes, _____ no.

If YES depth of formation _____

Why _____

Drillers Remarks: 300 gal on hr

3057

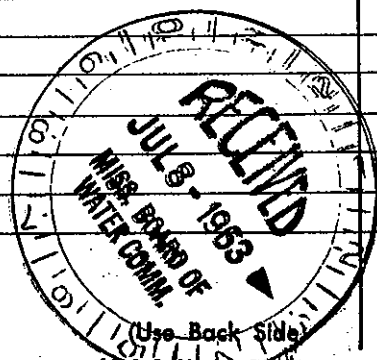

Well No.

Mail this copy to Board of Water Commissioners 429 Miss. St. Jackson, Miss