

15

WATER WELL DRILLERS LOG

8-30-63

ADDED
OK
can't locate

Date: 8-30, 1963, Driller: J.P. Thornton County _____
(Name)

(1) Owner of Land:	Description & Color of Materials Sand, Clay, Red Clay, Shell, etc.	Thick- ness Feet	Depth Feet
Tommy Alderman (Name) Carrhoge Miss (Address)	Red Clay	58	
Location: _____ 1/4, _____ 1/4, Sec. 9 T. 12N R. 8E	Black dirt	25	
1 miles E E, of Banner (distance) (direction) (Nearest Town)	fine Black sand	38	
(3) Topography: Hilly (Hilly) (Flat) (Level)	shells	2	
(4) Purpose of Well: Domestic (Domestic Irrigation Municipal, industrial, Other)	gray sand	32	
		15	


Information upon completion of well:

- (1) Diameter 2 inches.
- (2) Total Depth 208 feet.
- (3) Water Level 105' feet below top of ground.
- (4) Cased to 189, Size 2
- (5) Screen: Size 1 1/4, Length 6 ft
- (6) Were any formations sealed against pollution?
_____ yes, _____ no.

If YES depth of formation _____

Why _____

Drillers Remarks: 275' gal per hr

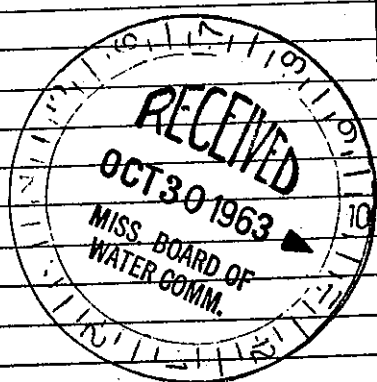

(Use Back Side)

Well No.