

CODED

Leake
C 21
1-10-70

MISSISSIPPI
BOARD OF WATER COMMISSIONERS
416 North State Street
Jackson, Mississippi 39201

WATER WELL DRILLERS LOG

Leake

1-10

1970

R. S. G. Miller


date well completed

firm name

county well located

LANDOWNER	description of formations encountered	from	to
<i>R. S. G. Miller</i>	<i>top soil</i>	<i>0</i>	<i>5</i>
<i>Carlhagen Mill</i>	<i>red sand</i>	<i>5</i>	<i>35</i>
(mailing address)	<i>pink sand</i>	<i>35</i>	<i>79</i>

WELL LOCATION:

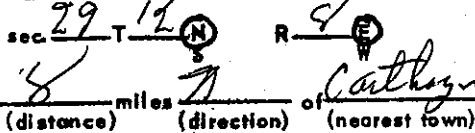

WELL PURPOSE: *Dom*
(home, irrigation, municipal, industrial)

WELL COMPLETION DATA:

- (1) diameter (inches) *4 1/4*
- (2) total depth (feet) *79*
- (3) static water level (feet) *43* below top of ground.
- (4) casing *P.R.M.* *75*
(material) (depth)
- (size) If telescope see back.
- (5) screen *4* *75*
(length) (depth to top)
- (size) *1* *R.R. L. pipe*
(material)
- (6) pump *3/4*
(HP) (yield gpm)
- (type power)
- (7) electric log (yes or no)
- (organization running log)
- (8) how well bottom plugged *1/2 plug*

FEB 24 1970

MISS. BD. OF
WATER COMM.

DRILLERS REMARKS: