

COMMISSIONERS

WELL DRILLERS LOG

CODED

C25 LEAKE C25

Date: 4-1-66, 1966, Driller: J P Thornton County Leake

4-1-66

(1) Owner of Land: Leon Bell
(Name)
Carthage Miss
(Address)

(2) Location: $\frac{1}{4}$, 14, Sec. 28 T. R.
8 miles NE of Carthage
(distance) (direction) (Nearest Town)

(3) Topography: (Hilly) (Flat) (Level)

(4) Purpose of Well: Domestic
(Domestic Irrigation, Municipal, Industrial, Other)

Description & Color of Materials Sand, Clay, Red Clay, Shell, etc.	Thick- ness Feet	Depth Feet
Red clay	25	
dry sand	40	
white chalk	2	
red sand with water	5	
Black dirt	107	
gray water sand	18	
	197	

Information upon completion of well:

(1) Diameter 2 inches.

(2) Total Depth 197 feet.


(3) Water Level ~~165~~ 65 feet below top of ground.

(4) Cased to 189, Size 2.

(5) Screen: Size 1/4, Length 68.

(6) Were any formations sealed against pollution?
yes, no,

1869

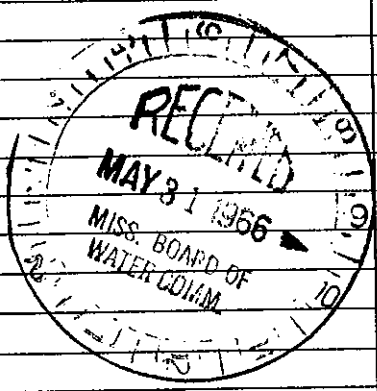

If YES depth of formation _____

Why _____

Drillers Remarks: 390 gal per hr

Well No.

(Use Back Side)

Mail this copy to Board of Water Commissioners 429 Miss. St. Jackson, Miss