Permit #: Driller: <u>Man 45</u> Dr.///// Date drilling completed: Z - 2 2 - 25	Mississippi Department of Enviro	Aquifer:
	Office of Land and Water R	
Date drilling completed C.	P.O. Box 10631 Jackson, MS 39289-0	631
	(601)961-5210	E-log #:
	(601)354-6938 (fax	
State Law requires that this re 30 days of completion of drillir		detail and filed with the Department within
Well Owner Inform		Well Location
Owner Name Joe Andy P	teltand Latitude	32 .50.688 " Longitude: 89.28.63
	uas N Method o	of Lat/Long (circle one): Conventional Survey.
Carthac	ms 39051 usa	GS quad, Hand-held GPS, Survey-grade GPS
City S	tate Zip Code	SE 1/4 Sec 23 CK Twn 12 N Rng 82
Telephone No. ()	Distance	Direction Nearest Town Miles SW of <u>Aentroe</u>
	Well Data	
Purpose of Well (circle one) Home I	ndustrial Public Supply Irrigat	tion Fish Culture Other: Far 4
Date well drilling started: $2 - 2$	2 - 06 Date well drill	ling completed: <u>2 - 21 - 06</u>
If flowing, method of flow regulation: N	Valve Other (describe)	)
Static Water Level: <u>60</u> feet	above or kelow errcle one) land surf	face Date measured: 2-22-06
Method of Measurement (circle one)	steel tape electric tape aii	r line other:
Hole depth: 205 Well d	lepth: <u>205</u> Well	grouted to a depth offeet
Type of grout (circle one): Cement	Bentonite Mix	
Casing length: <u>145</u> feet Ca	sing diameter: <u>4</u> inches	s Tune of costing: PIIC
Screen length: <u>20</u> feet Sc	reen diameter: <u>7</u> inche	s Type of screen:
Screen slot size:inches	Setting depth: From	feet to <u>205</u> feet
Type of completion (circle all applicable		· · ·
	Other (describe):	
Top of lap pipe or reduction in casing:	feet. If telescoped	l or more than one screen, describe on back of
Comparison of the Company	Electric Gamma Ray Densit	ty Sonic Neutron Other:
Name of organization running log(s):	nd completed in accordance	
t certify that the well was drilled, constructed, a Environmental Quality and/or the Mississippi D		able requirements of the Mississippi Department of
and of the mississippi D	eparament of mann regulations and state i	aws.
David 5. THOMAS	m 1/10	11

If well telescopes please sketch below and show depths.


MAR 0 9 2006 BY: OLWR

C-56

Ground Level	Description of Formations Encountered	From	То
	CLAY & DIrt	0	30
	Black Dirt	30	50
	Gray Clay	50	90
	Rock	90	91
	Green Stant	91	110
	Rock	110	111
	Green SAND	///	145
	Rock	145	146
	White SANA	146	,,
			Ĺ

If more than one screen, show location of each on sketch

• • • • •

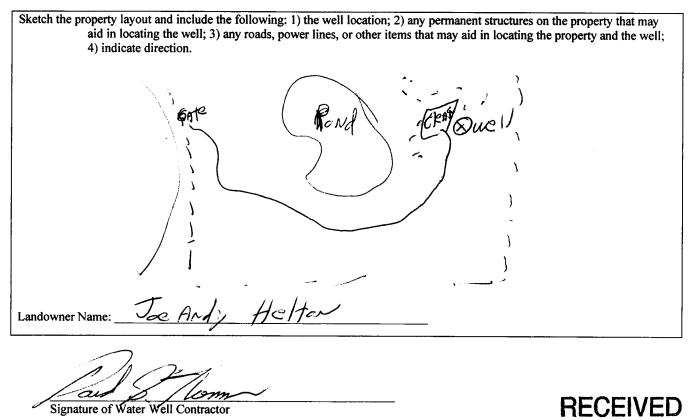

Signature of Water Well Contractor

MAR 0 9 2006 **BY: OLWR** 

			ELL REPORT			
County: Legke			art 2 Completion Report	For Office	Use Only:	
•		-		Aquifer: Well #:		
Permit #: Driller: $\underline{The MAS}$ Date completed: $\underline{Z}_{1}^{2} - \underline{Z}_{2}^{3}$	Drilling		t of Environmental Quality nd Water Resources	Well #:	56	
Driner. <u>7 10 - 7 3</u>	3-06		Box 10631	Elevation:		
Date completed: 2.	<u> </u>		1S 39289-0631 961-5210			
		(601)354	4-6938 (fax)			
			detail and filed with the D ist be attached to this repo		so days of the	
	ll Owner Inform		We	ell Location	0	
Owner Name:	0 ANDY	Helton	Latitude: 32,30.68	& Longitude: &	9 28.637	
Owner Name: <u>Joe Andy Helton</u>			Latitude: 32 30.688 Longitude: 89 28.637 <b>41</b> Method of Lat/Long (circle one): Conventional Survey,			
Mailing Address:	5-1 HU	MODN	Method of Lat/Long (circle one): Conventional Survey,			
5			USGS quad, Hand-held GPS, Survey-grade GPS			
Carthooe MS 39051 City State Zip Code			$\frac{1}{4} \frac{1}{4} \operatorname{Sec}_{33} \operatorname{Twn}_{2N} \operatorname{Rng}^{CE}$			
Telephone No. ()	)		$\_$ Miles $\le \mathcal{W}$	of Rentro	С	
		·····				
Pump Type			Power Type			
	Circle one			Circle one		
Air Lift	Jet	Submersible	Diesel Engine Gas	oline Engine	Natural Gas	
Bucket	Piston	Turbine	Electric Motor Ha	nd	Tractor PTO	
Centrifugal	Rotary	Flowing Well		ner (specify):		
Other (specify):			Horse Power Rating of Mc	otor: 1 =		
Date Pump Installed:	2-23-0	Б	Setting Depth: / 24	7	_feet	
Rated Pump Capacity:	27	Gallons Per Minute	Number of Stages: <u>10</u>			
	Pump Test Da	ta		feasuring Water Le	vel	
Date Well Tested:	-23-0	16		Circle one		
	1		Air Line Electric N	Measuring Line	Steel Tape	
Static Water Level (A)		Feet Below Land Surface	Other (specify):			
Pumping Water Level	(B): <u>//</u> 5I	Feet Below Land Surface	• • • • • • • • • • • • • • • • • • •			
Drawdown [(B) – (A)]		Feet Below Land Surface	For flowing well, measure	d shut in head:	feet	
Test Pumping Rate: <u>3</u> Gallons Per Minute			Well yielded GPM with a drawdown of			
Duration of Pump Test	(minimum 4 ho	urs): <u>/2</u> hours	feet afte	erh	ours of pumping	
HEREBY CERTIEV	that the above of	atements are true to the be	st of my knowledge			
		$\mathcal{O} = 14/7$		-6 -6		
NAVIA S. 1	1700 113	$\frac{O}{100000000000000000000000000000000000$	Signature of Pump Ins	taller	RECEIVE	
This mane of Pump In	istance and Lice	ise ino. (ii applicable)	Signature of Pump Ms		MAR 0 9 200	
				84		
				t	3 <b>Y:</b> OLW	

. . . \*

.