County: Lenke
Permit #: <b>GW- /6441</b>
Driller: ARKS
Date drilling completed: 5/8/08

## State Well Report

Part 1 - Driller's Log

Mississippi Department of Environmental Quality
Office of Land and Water Resources
P.O. Box 10631
Jackson, MS 39289-0631
(601)961-5210

(601)354-6938 (fax)

For Office Use Only:
Aquifer:
Well #:
L. S. Elevation:
E-log #:

State Law requires that this report be prepared by the license holder responsible for the work and filed with the Department at the above address within 30 days of completion of drilling of the well or borehole.


Department at the above agaress within 30 days of comp	neuon of arming of the weil or vorenoie.		
Information on Well Owner	Well or Borehole Location		
(Landowner if borehole is not for a water well)  Owner Name MARYOL WATER ASSW	Latitude:°' Longitude:°'"		
Mailing Address: 1588  Lawy 25 N  Carlhage, MS 3505/ City State Zip Code  Telephone No. ( )	Method of Lat/Long (circle one): Conventional Survey,  USGS quad, Hand-held GPS, Survey-grade GPS  NW 4 4 Sec 2 Twn 12N Rng 8E  Distance Direction Nearest Town  9 Miles NE of CARTAGE		
Well / Rore	hole Data		
Well / Borehole Data  Date drilling started: 2/30/8 Date drilling completed: 5/8/0 Hole depth: /// Hole diameter: 12 × 8  Location of the source of any surface water used for drilling:			
Method of dosing and volume of Chlorine used in drilling and development:  Logs run (circle all applicable): No log run Electric Gamma Ray Density Sonic Neutron Other:  Name of organization running log(s):			
Purpose of borehole (check one): Water Well  Geotechnical/Geole	ogical Investigation Ground Source Heat Pump		
Seismic SurveyOther (describe)  If drilling is not related to water well construction	n, skip the remainder of this block		
Purpose of Well (check one): Home Industrial Public Supply Irrigation Fish Culture Other:			
If a flowing well, method of flow regulation: ValveO	ther (describe)		
Static Water Level: 100 feet above or below (circle one) land surface Date measured: 5/13/08  Method of Measurement (circle one) steel tape electric tape air line other:			
Well depth: 1420 Well grouted to a depth of 1405 feet Type of grout (circle one): Neat Cement Bentonite Mix			
Casing length: 1355 feet Casing diameter: 12 inches Type of casing: 57ee			
Screen length: 80 feet Screen diameter: 8 inches Type of screen: Stainless Steel			
Screen slot size: 1020 inches Setting depth: From 1360 feet to 1440 feet			
Type of completion (circle all applicable). Gravel packed Underreamed Telescoped Open hole Natural Development			
Other (describe):			
Top of lap pipe or reduction in casing:			

Form: OLWR-SWR-1A

RECEIVED

JUN 0 3 2008

BY: OLWR

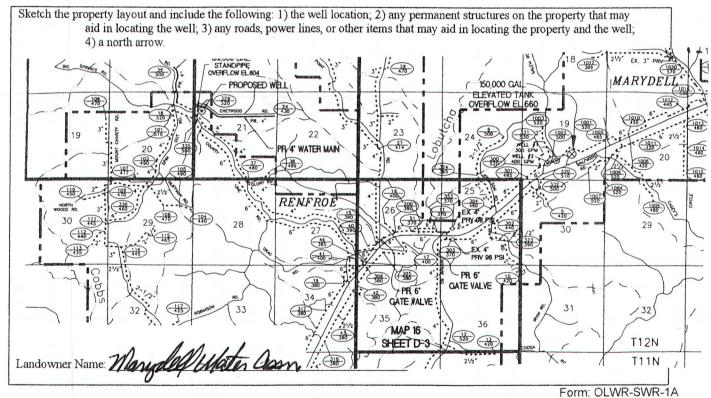

I certify that the well/borehole was drilled, constructed, and completed in accordance with all applicable requirements of the Mississippi Department of Environmental Quality and the Mississippi Department of Health regulations, if applicable, and state

laws

Print Name of Responsible Licensee and License No.

Signature of Licensee

RECEIVED

JUN 0 3 2008

BY: OLWR

## STATE WELL REPORT Part 2

## County: Lepke Permit #:

## Pump Installer's Completion Report

Mississippi Department of Environmental Quality
Office of Land and Water Resources
P.O. Box 10631

For	Office Use Only:
Aquifer:	
Well #:	C-61

Date completed: 3/8/8 (60	MS 39289-0631 1)961-5210 54-6938 (fax)  Well #:	
This part of the report must be completed by a licensed water well contractor or a licensed pump installer. A copy of Part 1 of the report must be attached and both parts filed with the Department at the above address within 30 days of well completion.  Well Owner Information  Well Location		
Owner Name: MARYDELL WATER ASSN.  Mailing Address: 1588  HWY 25W  CARTAGE MS 35057  City State Zip Code	Latitude: Longitude: Longitude: Method of Lat/Long (check one): Conventional Survey,  USGS quad, Hand-held GPS, Survey-grade GPS  NO 1/4 Sec 2/ T / 2N R 8/6	
Telephone No. ()	Distance Direction Nearest Town  9 Miles NE of CARThagE	
Pump Type Circle one	Power Type Circle one	
Air Lift Jet Submersible	Diesel Engine Gasoline Engine Natural Gas	
Bucket . Piston Turbine	Electric Motor Hand Tractor PTO	
Centrifugal Rotary Flowing Well	Windmill Other (specify):	
Other (specify):	Horse Power Rating of Motor:	
Pump Test Data	Method of Measuring Water Level	
Date Well Tested:  Static Water Level (A): 129 Feet Below Land Surface  Pumping Water Level (B): 249 Feet Below Land Surface	Circle one  Air Line Electric Measuring Line Steel Tape  Other (specify):	
Drawdown [(B) – (A)]:Feet Below Land Surface	For flowing well, measured shut in head:feet	
Test Pumping Rate: 500 Gallons Per Minute	Well yielded GPM with a drawdown of	
Duration of Pump Test (minimum 4 hours):hours	feet afterhours of pumping	
I HEREBY CERTIFY that the above statements are true to the best  A 4 Company facts D-4/4  Print Name of Pump Installer and License No. (if applicable)	of my knowledge  Signature of Pump Installer  RECEIVE	

I HEREBY CERTIFY that the above statements are true to the best of	of my knowledge
Kan Daling-um	
Dayburn facts 8-414	Signatura & Burna Installer BECEIV

Form: OLWR-SWR-1B