

LEAKE MISSISSIPPI BOARD OF WATER COMMISSIONERS

WATER WELL DRILLERS LOG

CODED

D4
5-24-62


Date: 5-24, 1962, Driller: Heenan County Leake
(Name)

(1) Owner of Land: (Name)	Description & Color of Materials Sand, Clay, Red Clay, Shell, etc.	Thick- ness Feet	Depth Feet
<u>Willie Bruch</u>	<u>Very Red Sand Clay</u>		<u>24</u>
<u>Rt 5 Kosejnsko</u> (Address)	<u>Yellow-Red Sand Clay</u>	<u>23</u>	<u>47</u>
(2) Location: <u>NW 1/4, SW 1/4, Sec. 4 T12R9</u>	<u>Yellow Sand</u>	<u>15</u>	<u>62</u>
<u>17</u> miles <u>NE</u> of <u>Carthage</u> (distance) (direction) (Nearest Town)	<u>Tan & Green Peppar</u>	<u>8</u>	<u>70</u>
(3) Topography: <u>Hilly</u> (Hilly) (Flat) (Level)	<u>Cream Sand</u>	<u>9</u>	<u>79</u>
(4) Purpose of Well: <u>Domestic</u> (Domestic Irrigation Municipal, Industrial, Other)			

Information upon completion of well:

- (1) Diameter 2 inches.
- (2) Total Depth 79 feet.
- (3) Water Level 47 feet below top of ground.
- (4) Cased to 72, Size 2"
- (5) Screen: Size 1/4, Length 4
- (6) Were any formations sealed against pollution?
 yes, no.

If YES depth of formation _____
Why _____
Drillers Remarks: _____

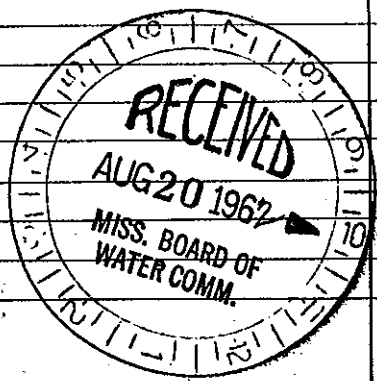

(Use Back Side)

Well No.

Mail this copy to Board of Water Commissioners 429 Miss. St. Jackson, Miss.