

Leake
75

MISSISSIPPI BOARD OF WATER COMMISSIONERS

WATER WELL DRILLERS LOG

CODED

7-66

Date: 7-27, 1966, Driller: Henson Drilling County Leake

(Name)

(1) Owner of Land: E. D. Alexander
(Name)

Carthage, Miss
(Address)

(2) Location: NE 1/4, SW 1/4, Sec. 23 T12R9,

1 1/2 miles N 6 of Carthage
(distance) (direction) (Nearest Town)

(3) Topography: (Hilly) (Flat) (Level)

(4) Purpose of Well: Domestic
(Domestic Irrigation, Municipal, Industrial, Other)

Description & Color of Materials
Sand, Clay, Red Clay, Shell, etc.

Thick-
ness
Feet

Depth
Feet

<u>Clay</u>	<u>0</u>	<u>20</u>
<u>Clay Sand Mixture</u>	<u>35</u>	<u>55</u>
<u>Loam</u>	<u>2</u>	<u>58</u>
<u>Water Sand</u>	<u>26</u>	<u>84</u>

Information upon completion of well:

(1) Diameter 2 inches.

(2) Total Depth 84 feet.

(3) Water Level 53 feet below top of ground.

(4) Cased to 79, Size _____.

(5) Screen: Size 1/4, Length 4

#1008 Well SS

(6) Were any formations sealed against pollution?


_____ yes, _____ no.

If YES depth of formation _____

Why _____

Drillers Remarks:

Covered Ground
Casing at Top

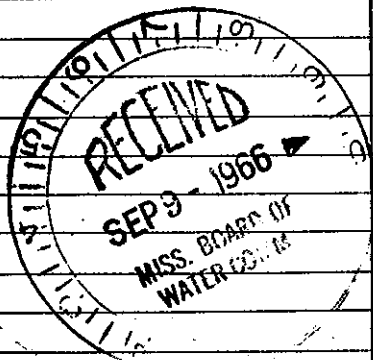

(Use Back Side)

Well No. _____

Mail this copy to Board of Water Commissioners 429 Miss. St. Jackson, Miss.