

Leake  
D9  
7-68 CODED

MISSISSIPPI BOARD OF WATER COMMISSIONERS

WATER WELL DRILLERS LOG

Date: 7-24, 1968 (When well drilled) Driller: Thomasson (Name) County: Leake (Where well is located)

(1) Owner of Land: J. B. Brock  
Hwy 25 N (Name)  
Carthage, Miss. (Address)

(2) Location: NW 1/4, NW 1/4, Sec 2, T12R9  
Store at Marydale  
 \_\_\_\_\_ miles \_\_\_\_\_ of \_\_\_\_\_  
 (distance) (direction) (Nearest Town)

(3) Topography: (Hilly) (Flat) (Level)

(4) Purpose of Well: (Domestic) Irrigation  
 Municipal, Industrial, Other

Description & Color of Materials Sand, Clay, Red Clay, Shell, etc.	Thick- ness Feet	Depth Feet
Red Sandy Clay	0	42
Black Dirt	42	95
Stks Sand & Black Dirt	95	115
White Sand	115	132

Information upon completion of well:

(1) Diameter 2 inches.

(2) Total Depth 132 feet.

(3) Water Level 90 feet below top of ground.

(4) Cased to 126, Size 2"  
35/64 S.S.

(5) Screen: Size 1 1/4", Length 6'

(6) Were any formations sealed against pollution?  
 \_\_\_\_\_ yes,  no.

If YES depth of formation \_\_\_\_\_

Why \_\_\_\_\_



Drillers Remarks: \_\_\_\_\_

Yield in gpm: 7

Size pump: 1 H.P.

Type power: Elec

CODED

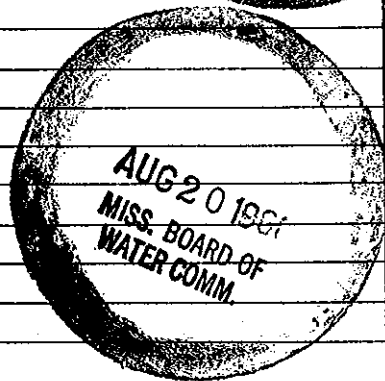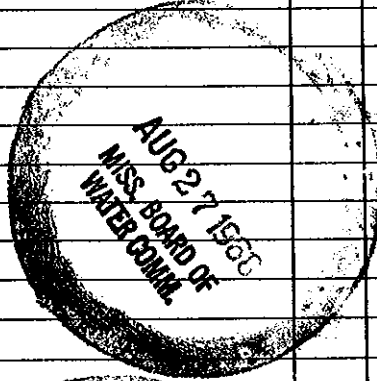

Mail this copy to Board of Water Commissioners 429 Miss. St. Jackson, Miss.