

3 13T

325058N0892055

CODED

Leake
D10
9-23-68

MISSISSIPPI
 BOARD OF WATER COMMISSIONERS
 416 North State Street
 Jackson, Mississippi 39201

TETA

WATER WELL DRILLERS LOG

9-23-68 date well completed
 Thomas Son firm name
 Leake county well located

LANDOWNER: Jack Horwe
 Edinburg
 Miss.
 (mailing address)


WELL LOCATION:
 sec. 35 T 12 N R 9 E
 S W
 3 1/2 miles N of Edinburg
 (distance) (direction) (nearest town)

WELL PURPOSE:
 (home, irrigation, municipal, industrial)

WELL COMPLETION DATA:

- (1) diameter (inches) 2
- (2) total depth (feet) 93
- (3) static water level (feet) 70 below top of ground.
- (4) casing GALV. 28' (material) (depth)
 2" (size) if telescope see back.
- (5) screen 5' 28' (length) (depth to top)
 1 1/4" 8 slot stainless (size) (material)
- (6) pump 1 (HP) 7 (yield gpm)
 Elec (type power)
- (7) electric log NO (yes or no)
 (organization running log)
- (8) how well bottom plugged

description of formations encountered	from	to
Red Clay	0	10
Red Mottled Sand	10	30
Chalk + Sand	30	65
Some Sand Rock		
White Sand	65	93

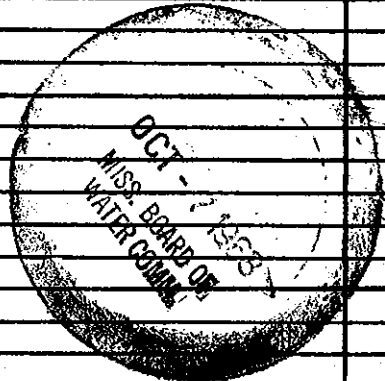

DRILLERS REMARKS: