| County: LEAKE | Well Driller Re | port and Well Log | For Office Use Only: | |
|--|---|---|---|--|
| Permit #: Driller: Thom As Drilling Date drilling completed: <u>9-21-05</u> | Mississippi Department of Environmental Quality Office of Land and Water Resources P.O. Box 10631 Jackson, MS 39289-0631 (601)961-5210 (601)354-6938 (fax) | | Aquifer: | |
| State Law requires that this r 30 days of completion of drilli | | driller in detail and filed with | a the Department within | |
| Well Owner Inform Owner Name Brent R Mailing Address: 2636 | nation Hivewalt #1 Pemvs' Rd | Method of Lat/Long (circle of | Location - 99.34311 "Longitude: 89.20 38 ne): Conventional Survey, | |
| CAN-THE AGE City | | USCIS quad, Harden $5W$ 4 NE 4 Sec 26 Distance Direction | Survey-grade GPS Twn / 2 N Rng 9 E Nearest Town of $N = MBS$ | |
| | Well | Data | | |
| Purpose of Well (circle one) Home Date well drilling started: 2^{-2} If flowing, method of flow regulation: Static Water Level: 5^{-2} fee Method of Measurement (circle one) Hole depth: 2^{-2} Well Type of grout (circle one): Cemera Casing length: 2^{-2} feet C Screen length: 2^{-2} feet S Screen slot size: 2^{-2} inche Type of completion (circle all applicable Top of lap pipe or reduction in casing: | $27 - 0.5$ Da Valve Other valve or below (circle or steel tape electric ta depth: 100^{1} Bentonite M value diameter: 4 Screen diameter: 4 es Setting depth: From le): Gravel packed Un Other (describe): | te well drilling completed: r (describe) ne) land surface Date measur ape air line other: Well grouted to a depth of fix inches Type of casing inches Type of screen nfeet to derreamed Telescoped O | $\frac{7-27-25}{100}$ ed: $\frac{7-27-25}{100}$ feet $\frac{97}{100}$ feet $\frac{97}{100}$ feet pen hole Natural Development | |
| Logs run (circle all applicable): No tog | | | | |
| Name of organization running log(s): I certify that the well was drilled, constructed, | - | | | |
| Environmental Quality and/or the Mississippi | | | | |

0-147 DAVID S. Thomas

If well telescopes please sketch below and show depths.

Print Name of Water Well Contractor and License No.

,

, ×

00:26 Mile


Signature of Water Well Contractor

BY OLWR

D- 30

| Ground Level | Description of Formations Encountered | From To |
|--------------|---------------------------------------|---------|
| | C/AV | 0 (|
| | | |
| | Rg'C K | |
| | CAY | 19 25 |
| | Rock | 25 42 |
| | Gray SAND | 42 100 |
| | | |
| | | |
| | ······ | |
| | | |
| | | |
| I | | l |

If more than one screen, show location of each on sketch

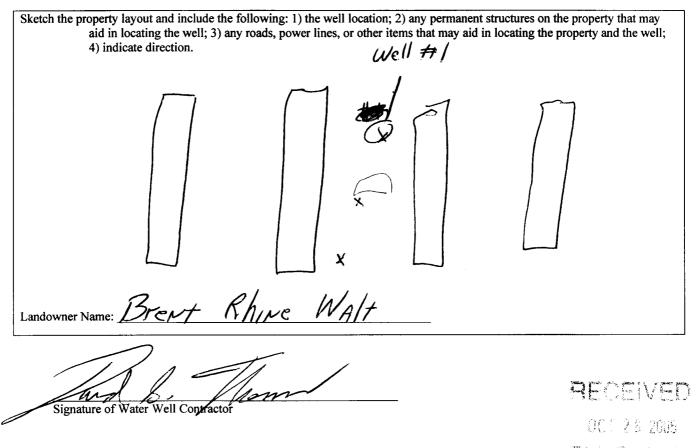

BY OLWR

| | | | ELL REPORT | | |
|---|---------------|---------------------------------|---|--|--------------|
| County: LCAKC | | = | Part 2 S Completion Report | For Office | Use Only: |
| | | - Mississippi Departmer | nt of Environmental Quality | Aquifer: | 30 |
| Permit #: Driller: <u></u> Date completed:] - 2.8 | Drilling | Office of Land | and Water Resources Box 10631 | Elevation: | |
| Date completed: 7 - 28 | 3-195 | Jackson, N | AS 39289-0631 | | |
| L | | (601)35 |)961-5210 54-6938 (fax) | | |
| | | | detail and filed with the I ust be attached to this rep | | 0 days of th |
| | l Owner Infor | | | ell Location | |
| Owner Name: <u>3ren</u> | ut KhII | vewalt #! | Latitude: 32.867/ | 8Longitude:8 | 19.3431 |
| Mailing Address: <u>26</u> | 36 1 | emus Rd | Method of Lat/Long (circ | le one): Convention | al Survey, |
| | | | USGS quad, 1 | Hand-held OPS, Sur | vey-grade G |
| CAr | the Age 1 | <u>M5 3905</u> tate Zip Code | ¹ /4 ¹ /4 Sec | | - |
| City | / s | tate Zip Code | Distance Direction | | , |
| Telephone No. () | | | <u>14</u> Miles <u>E</u> | | |
| | | | | | |
| | Pump Type | | | Power Type | <u> </u> |
| | Circle one | \frown | | Circle one | |
| Air Lift | Jet | Submersible | Diesel Engine Ga | soline Engine | Natural |
| Bucket | Piston | Turbine | Electric Motor H | and | Tractor P |
| Centrifugal | Rotary | Flowing Well | Windmill Of | her (specify): | |
| Other (specify): | | | Horse Power Rating of M | otor: <u>/</u> | |
| Date Pump Installed: | 9-28-0 | 5 | Setting Depth: 80 | | feet |
| | | Gallons Per Minute | Number of Stages: 9 | | |
| | | | | ······································ | |
| Pump Test Data | | | | Measuring Water Lev | rel |
| Date Well Tested: | | 25 | | Circle one | a |
| Static Water Level (A): Feet Below Land Surface | | | | Measuring Line | Steel Tap |
| Pumping Water Level (| | Feet Below Land Surface | Other (specify): | | |
| | | Feet Below Land Surface | For flowing well, measure | ed shut in head: | f |
| | , | Gallons Per Minute | Well yielded | | |
| Duration of Pump Test | | 1 | | | |
| | (minimum 4 no | nours | | erho | ours of pump |
| | 1 | tatements are true to the be | t = (| | |

| BY: OLVF | 5 | | 4. | in the second | 5). 1 | ý | - | Surfaces. | at. | Contraction of the local data |
|----------|---|--|----|---------------|-----------|---|---|-----------|-----|-------------------------------|
|----------|---|--|----|---------------|-----------|---|---|-----------|-----|-------------------------------|