

Leake

MISSISSIPPI BOARD OF WATER COMMISSIONERS

F7

WATER WELL DRILLERS LOG

CODE

7-66

Date: 7-1, 1966, Driller: James Dickey, County: Leake

(Name)

(1) Owner of Land:	Description & Color of Materials Sand, Clay, Red Clay, Shell, etc.	Thick- ness Feet	Depth Feet
Mrs J C Murphy (Name)	Clay	0	10
Carters, Miss (Address)	Sand & Clay	30	40
	Water Sand	10	50
(2) Location: SE 1/4, SE 1/4, Sec. 1 T11R7,			
7 miles NE of Carters			
(distance) (direction) (Nearest Town)			
(3) Topography: <input checked="" type="checkbox"/> (Hilly) <input type="checkbox"/> (Flat) <input type="checkbox"/> (Level)			
(4) Purpose of Well: Domestic			
(Domestic Irrigation Municipal, Industrial, Other)			

Information upon completion of well:


- (1) Diameter 2 inches.
- (2) Total Depth 50 feet.
- (3) Water Level ? feet below top of ground.
- (4) Cased to 44, Size
- (5) Screen: Size 1/4", Length 4' GESS #1006
- (6) Were any formations sealed against pollution?
 yes, no.

If YES depth of formation

Why

Drillers Remarks:

Concrete Around
Pipe at top

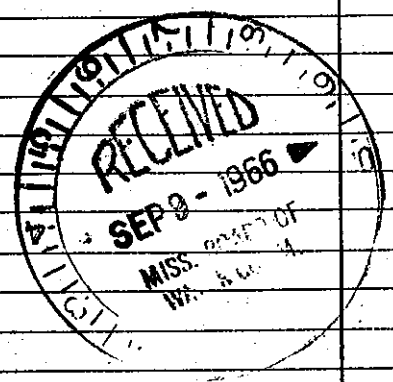

Well No.

(Use Back Side)

Mail this copy to Board of Water Commissioners 429 Miss. St. Jackson, Miss