

LEAKE

WATER WELL DRILLERS LOG

CODED

F 8

10-30-62

Date: 10-30, 1962, Driller: Nearon County Leake

(Name)

(1) Owner of Land: <u>Nellie Wilder</u> (Name)	Description & Color of Materials Sand, Clay, Red Clay, Shell, etc.	Thick- ness Feet	Depth Feet
<u>RFD Carthage, Miss.</u> (Address)	<u>Yellow Clay</u>	<u>5</u>	<u>5</u>
(2) Location: <u>1/4, 1/4, Sec. 14 T11R7,</u>	<u>Red Clay</u>	<u>3</u>	<u>8</u>
<u>6</u> miles <u>NW</u> of <u>Carthage</u>	<u>Red clay sand</u>	<u>9</u>	<u>17</u>
(distance) (direction) (Nearest Town)	<u>Green Sand/Clay</u>	<u>8</u>	<u>25</u>
(3) Topography: <u>Hilly</u>	<u>Sandstone</u>	<u>12</u>	<u>37</u>
(Hilly) (Flat) (Level)	<u>Chert/Concretion</u>	<u>5</u>	<u>42</u>
(4) Purpose of Well: <u>Domestic</u>	<u>Sandstone & fine sand</u>	<u>23</u>	<u>65</u>
(Domestic Irrigation Municipal, Industrial, Other)	<u>Grey Sand</u>	<u>76</u>	<u>80</u>


Information upon completion of well:

- (1) Diameter 2 inches.
- (2) Total Depth 80 feet.
- (3) Water Level 48 feet below top of ground.
- (4) Cased to 73, Size 2
- (5) Screen: Size 1/4, Length 6
- (6) Were any formations sealed against pollution?
 yes, no.

If YES depth of formation _____

Why _____

Drillers Remarks: _____

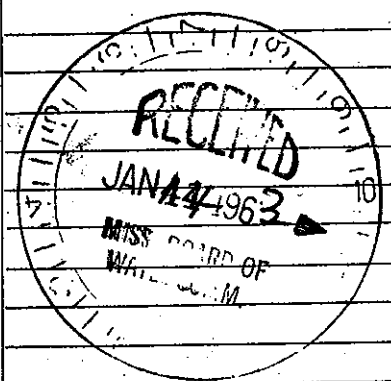

(Use Back Side)

Well No. _____