

LEAKE MISSISSIPPI BOARD OF WATER COMMISSIONERS

F9

10-2-62

WATER WELL DRILLERS LOG

CODED

Date: 10-2, 1962, Driller: Hearon County Leflore


(Name)

(1) Owner of Land: <u>Red Water Lading School</u> (Name)	Description & Color of Materials Sand, Clay, Red Clay, Shell, etc.	Thick- ness Feet	Depth Feet
<u>Carthage, Miss</u> (Address)	<u>Red Clay</u>	<u>17</u>	<u>17</u>
(2) Location: <u>1/4, 1/4, Sec 36 T11R7</u>	<u>White Sand Rock</u>	<u>4</u>	<u>21</u>
<u>2 miles N</u> of <u>Carthage</u> (distance) (direction) (Nearest Town)	<u>Snap Stone</u>	<u>11</u>	<u>32</u>
(3) Topography: <u>Hilly</u> (Hilly) (Flat) (Level)	<u>Snap Stone & White Sand</u>	<u>10</u>	<u>42</u>
(4) Purpose of Well: <u>School</u> (Domestic Irrigation Municipal, Industrial, Other)	<u>006 White Sand Mic</u>	<u>13</u>	<u>55</u>
	<u>Red Sand</u>	<u>10</u>	<u>65</u>
	<u>Tan Sand</u>	<u>7</u>	<u>72</u>
	<u>008 Tan Sand</u>	<u>8</u>	<u>80</u>
	<u>006 Red Sand</u>	<u>07</u>	<u>87</u>
	<u>010 Brown Sand</u>	<u>9</u>	<u>96</u>
	<u>010 White Sand</u>	<u>16</u>	<u>112</u>
	<u>008 Gray White Sand</u>	<u>5</u>	<u>117</u>
	<u>Gray Clay Sand</u>	<u>123</u>	<u>170</u>
	<u>Gray Clay</u>	<u>68</u>	<u>238</u>
	<u>Rock</u>	<u>4</u>	<u>242</u>
	<u>Black clay</u>	<u>10</u>	<u>252</u>
	<u>Shale Rock</u>	<u>2</u>	<u>254</u>
	<u>Black to green limestone</u>	<u>22</u>	<u>276</u>
	<u>Rock w/ shells</u>	<u>1</u>	<u>277</u>
	<u>Green limestone</u>	<u>25</u>	<u>302</u>
	<u>Gray Sand</u>	<u>10</u>	<u>312</u>
	<u>Brown Sand</u>	<u>20</u>	<u>332</u>

Information upon completion of well:

- (1) Diameter 6 inches.
- (2) Total Depth 136 feet.
- (3) Water Level 22 1/2 feet below top of ground.
- (4) Cased to 126, Size 6"
- (5) Screen: Size 4", Length 10 ft.
- (6) Were any formations sealed against pollution?
yes, no.

If YES depth of formation _____
Why _____
Drillers Remarks: _____

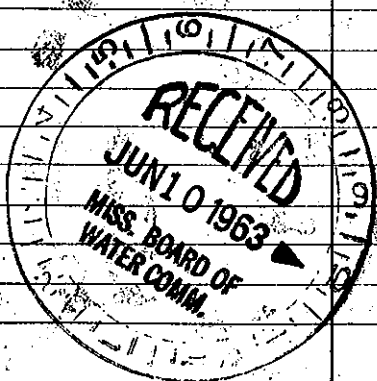

(Use Back Side)

Well No.

Mail this copy to Board of Water Commissioners 429 Miss. St. Jackson, Miss