

LEAKE

MISSISSIPPI BOARD OF WATER COMMISSIONERS

F10

CODED

6-18-62

WATER WELL DRILLERS LOG

Date: 6-18, 1962, Driller: Hearn Drilling County Leake

(Name)

(1) Owner of Land: <u>W.D. Flowers</u> (Name)	Description & Color of Materials Sand, Clay, Red Clay, Shell, etc.	Thick- ness Feet	Depth Feet
<u>RT 2, Carthage</u> (Address)	<u>Mix Red &amp; White Clay</u>		<u>9</u>
(2) Location: <u>W 1/4, E 1/4, Sec. 20 N 1/4 R 6</u>	<u>White &amp; Yellow Clay</u>	<u>7</u>	<u>16</u>
<u>5</u> miles <u>NW</u> , of <u>Carthage</u> (distance) (direction) (Nearest Town)	<u>Iron ore</u>	<u>4</u>	<u>20</u>
(3) Topography: <u>Hilly</u> (Hilly) (Flat) (Level)	<u>Fine white pebbles</u>	<u>40</u>	<u>-</u>
(4) Purpose of Well: <u>Domestic</u> (Domestic Irrigation Municipal, Industrial, Other)	<u>Sand &amp; Gravel</u>	<u>-</u>	<u>60</u>
	<u>Tan pebbles sand</u>	<u>12</u>	<u>72</u>


Information upon completion of well:

- (1) Diameter 2 inches.
- (2) Total Depth 72 feet.
- (3) Water Level 42 feet below top of ground.
- (4) Cased to 65, Size 2
- (5) Screen: Size 1 1/4, Length 6 ft
- (6) Were any formations sealed against pollution?  
no

If YES depth of formation \_\_\_\_\_

Why \_\_\_\_\_

Drillers Remarks: \_\_\_\_\_

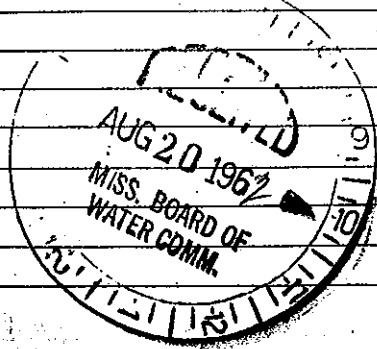

(Use Back Side)

Well No.

Mail this copy to Board of Water Commissioners 429 Miss. St. Jackson, Miss.