

LEAKE

MISSISSIPPI BOARD OF WA

F 12  
8-3-61

WATER WELL DRILLERS LOG

7 CODED

Date: 8-3, 1961, Driller: J P Thant County Leake  
(Name)

(1) Owner of Land:	Description & Color of Materials	Thick-ness Feet	Depth Feet
D H Bennett (Name)	red clay	21	
Carthage miss (Address)	dry sand	40	
(2) Location: 1/4, 1/4, Sec. 25 T11R7	real fine sand	20	
1 1/2 miles north of Carthage (distance) (direction) (Nearest Town)	real coarse water sand	13	
(3) Topography: Lilly (Hilly) (Flat) (Level)			
(4) Purpose of Well: Domestic (Domestic Irrigation, Municipal, Industrial, Other)			


Information upon completion of well:

- (1) Diameter: 2 inches.
- (2) Total Depth: 94 feet.
- (3) Water level: 50 feet below top of ground.
- (4) Cased to: 88, Size: 2"
- (5) Screen: Size: 1 1/4, Length: 6 ft, 80 gals
- (6) Were any formations sealed against pollution?  
\_\_\_\_\_ yes, \_\_\_\_\_ no.

If YES depth of formation \_\_\_\_\_

Why \_\_\_\_\_

Drillers Remarks: 3 5' gal per hr.

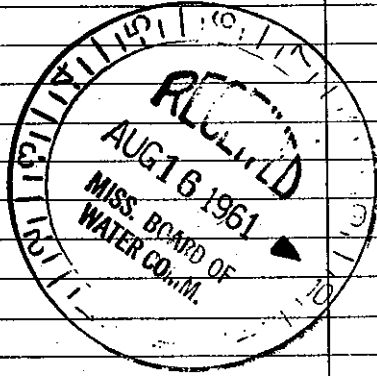

(Use Back Side)

Well No.

Mail this copy to Board of Water Commissioners 429 Miss. St. Jackson, Miss