

COMMISSIONERS

LEAKE
F 75

WATER WELL DRILLERS LOG

CODED

Date: 3-30-61, 1961, Driller: J P Sheritor County Leake

(Name)

(1) Owner of Land:	Description & Color of Materials Sand, Clay, Red Clay, Shell, etc.	Thick- ness Feet	Depth Feet
Joe Soderstrom (Name)	Clay	40	
Carthage miss (Address)	Black Dirt	20	
15 119 (Address)	sand + clay mix	20	
(2) Location: 1/4, 1/4 Sec T R	white water sand	25'	
3 miles S Conway, of Conway (distance) (direction) (Nearest Town)			
Hilly (Hilly) (Flat) (Level)			
Domestic (Domestic Irrigation Municipal, Industrial, Other)	2689		


Information upon completion of well:

- (1) Diameter 2 inches.
- (2) Total Depth 105 feet.
- (3) Water Level 60 feet below top of ground.
- (4) Cased to 100, Size 2"
- (5) Screen: Size 1/4, Length 6 ft
- (6) Were any formations sealed against pollution?
yes, no.

If YES depth of formation

Why

Drillers Remarks: 380 gal per hour

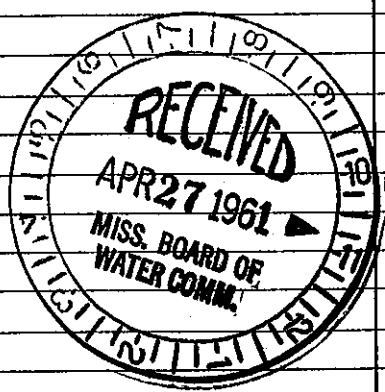

Well No.

(Use Back Side)

Mail this copy to Board of Water Commissioners 429 Miss. St. Jackson, Miss.