

LEAKE
F 17
3-30-62

WATER WELL DRILLERS LOG

CODED

Date: 3-31, 1962, Driller: J.P. Thornton County Leake
(Name)

(1) Owner of Land:	Description & Color of Materials Sand, Clay, Red Clay, Shell, etc.	Thick- ness Feet	Depth Feet
Ollie Yannon (Name) Carthage Miss (Address)	red clay	25	20
4 11-7 (Address)	dry sand	26	46
(2) Location: 1/4, 1/4, Sec. T. R. 8 miles north of Carthage (distance) (direction) (Nearest Town)	gray chalk	18	56
(3) Topography: hilly (Hilly) (Flat) (Level)	gray water sand	13	69
(4) Purpose of Well: Domestic (Domestic Irrigation Municipal, Industrial, Other)	1018		


Information upon completion of well:

- (1) Diameter 2 inches.
- (2) Total Depth 69 feet.
- (3) Water Level 45 feet below top of ground.
- (4) Cased to 62, Size 2
- (5) Screen: Size 1 1/4, Length 6 ft.
- (6) Were any formations sealed against pollution?
_____ yes, _____ No.

If YES depth of formation _____

Why _____

Drillers Remarks: 40' gal Per hr.

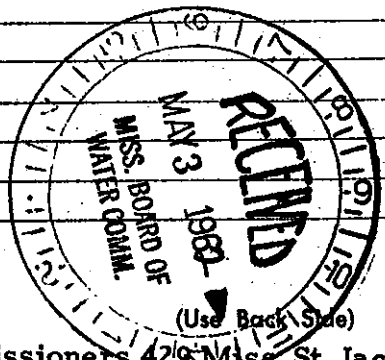

Well No.

Mail this copy to Board of Water Commissioners 429 Miss. St. Jackson, Miss