

LEAKE

MISSISSIPPI BOARD OF WATER COMMISSIONERS

F 20

CODED

3-20-63

WATER WELL DRILLERS LOG

Date: 3-20, 1963, Driller: J.P. Thornton County Leake (Name)

(1) Owner of Land:	Description & Color of Materials Sand, Clay, Red Clay, Shell, etc.	Thick- ness Feet	Depth Feet
Haywood Harper (Name)	Yellow Chalk	50	
Carthage miss (Address)	Black dirt	35	
(2) Location: 1/4, 3 1/4, Sec. 11, T. 7, R. 7	Rock	2	
2 miles N.W., of Carthage (distance) (direction) (Nearest Town)	Water Pond Pink	50	
(3) Topography: hilly (Hilly) (Flat) (Level)	Chalk	10	
(4) Purpose of Well: Domestic (Domestic Irrigation, Municipal, Industrial, Other)	Rock	4	
	Shell	21	
	Rock	3	
	white water sand	20	
		195	


Information upon completion of well:

- (1) Diameter 2 inches.
- (2) Total Depth 195' feet.
- (3) Water level 90 feet below top of ground.
- (4) Cased to 185', Size 2"
- (5) Screen: Size 1/4", Length 6 ft.
- (6) Were any formations sealed against pollution?
yes, no.

If YES depth of formation

Why

Drillers Remarks: 600 gal Per hr.

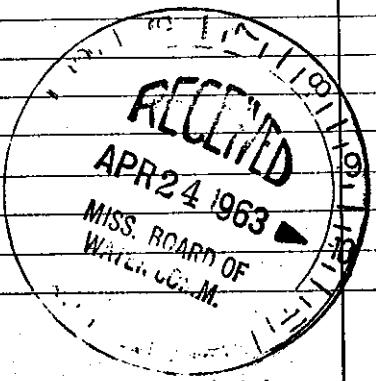

(Use Back Side)

Well No.

Mail this copy to Board of Water Commissioners 429 Miss. St. Jackson, Miss